

National Grid SA-CO **PRODUCTION FILE**

Contractor : ABB Contracting Co.

Project : SS 8709- 132/13.8kV in Alkha

Contract No : 11131113/00

Substation : 8709

**Subject : 132Kv Busbar Protection Set-
Relay Panel-5**






POWER SYSTEMS NETWORK MANAGEMENT
PROTECTION AND SUBSTATION AUTOMATION SYSTEMS
WBS NO: S-13656

ABB AUTOMATION COMPANY LTD.
414, AL-KHARJ ROAD
SECOND INDUSTRIAL CITY
RIYADH-11383 K.S.A

CONTRACTOR : ABB Contracting Company
CLIENT : National GridSA
PROJECT : CONSTRUCTION OF NEW 132/13.8kV SS 8709 IN AL-KHARJ CITY
SUBSTATION : S/S 8709
CONTRACT NO. : 11131113/00
TITLE : Assembly Drawing - +BBP1-5
[132KV BUSBAR PROTECTION MAIN-1 BAY UNIT PANEL]

AS-BUILT BY _____ DATE _____			CONTRACT NO. 11131113/00		JOB ORDER NO. S-13656		COVER SHEET		الشركة الوطنية لنقل الكهرباء نقل الكهرباء National Grid sa					
01	13 49	FACTORY ASBUILT	DRAWN BY RIZ		CHECKED BY KVR		132KV BUSBAR PROTN.MAIN-1 BU PANEL +BBP1-5		INDEX	PLANT NO.	DRAWING NUMBER	SHEET NO.	REV. NO.	
00	13 05	FOR APPROVAL	DATE STARTED 28.01.2013		DATE COMPLETED		S/S 8709 - 132/13.8KV IN AL-KHARJ CITY		-	C421	CD-322998	SHT	CONT.	
REV. NO.	DATE	DESCRIPTION	OPRG. DEPT. CTPD		ENG. DEPT. AUT-PSAC		RIYADH SAUDI ARABIA					G00	G01	01

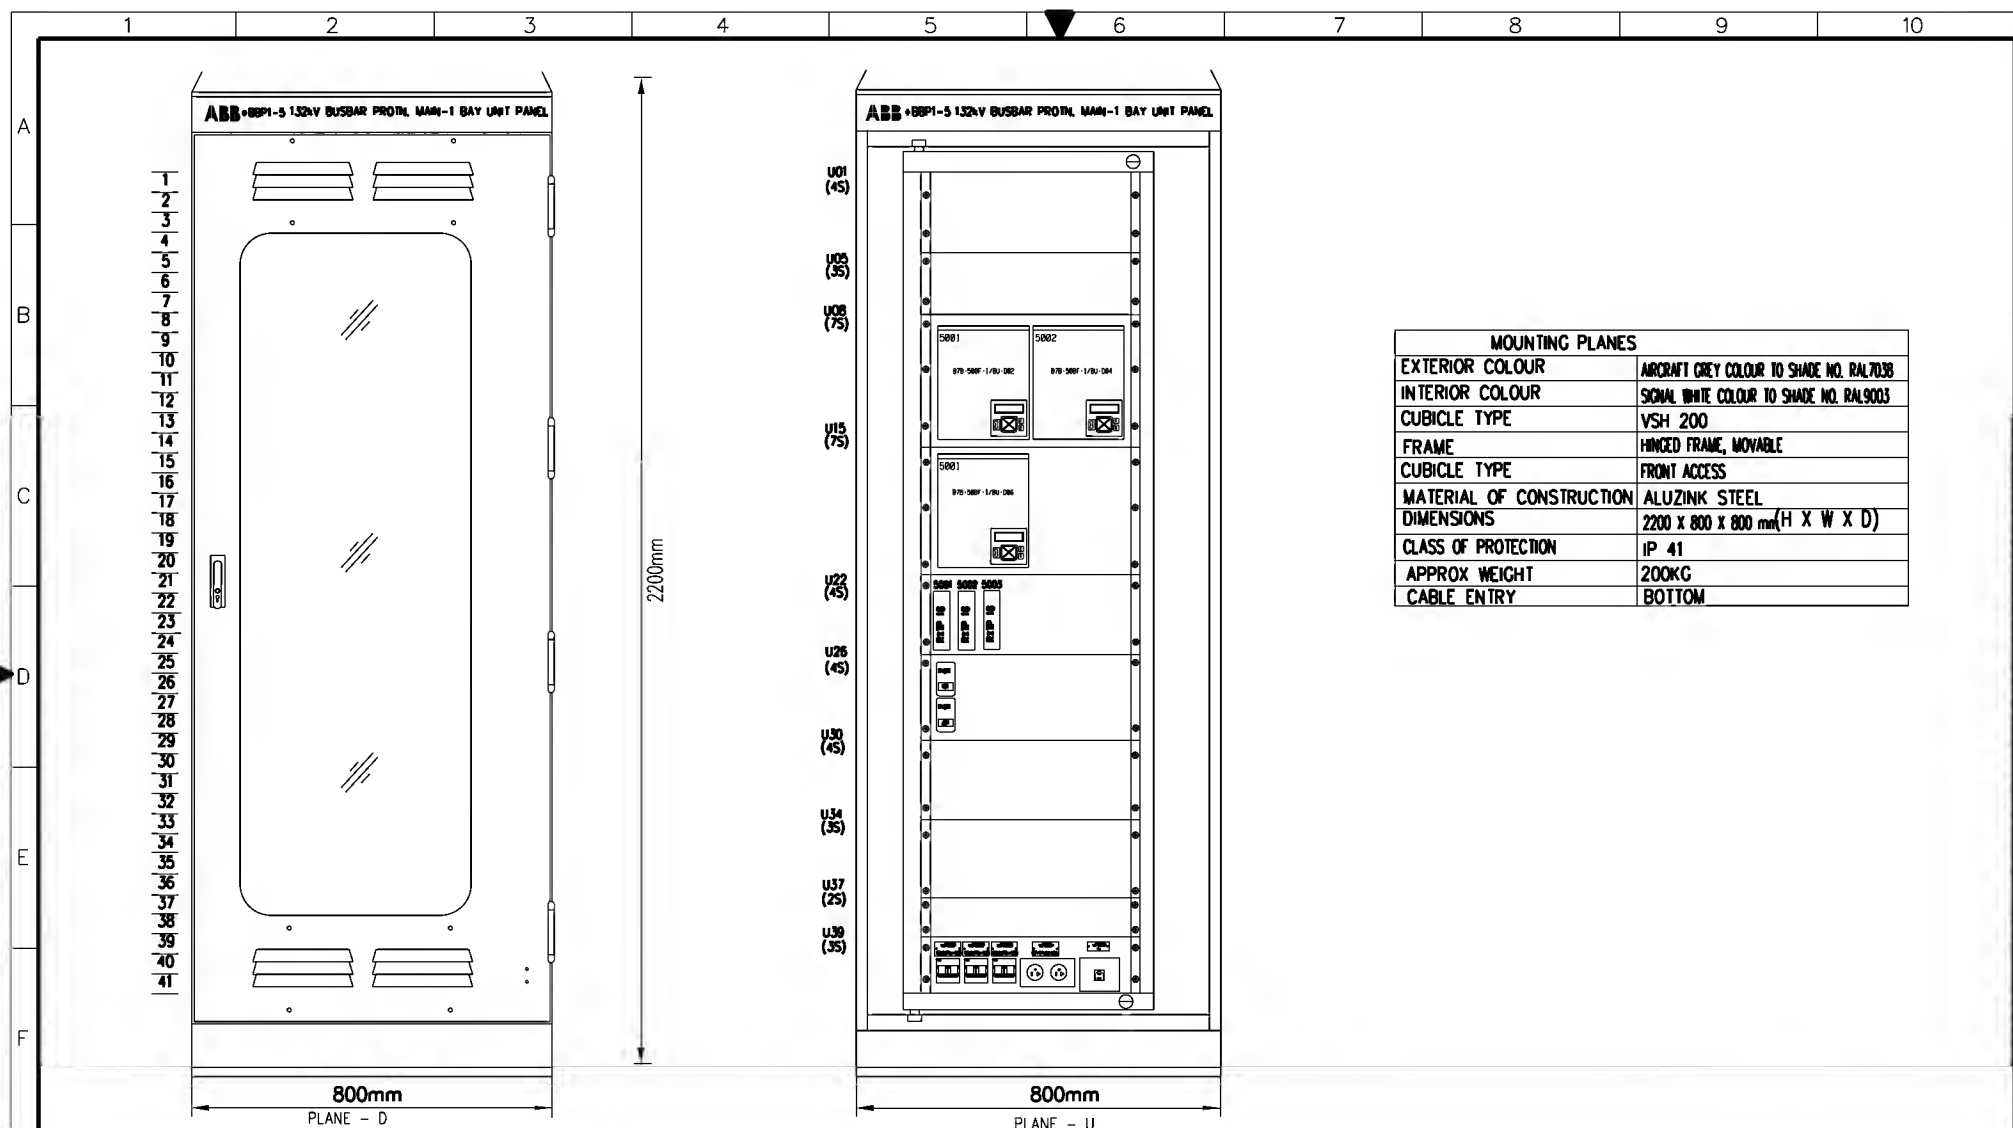

MOUNTING PLANES	
EXTERIOR COLOUR	AIRCRAFT GREY COLOUR TO SHADE NO. RAL7038
INTERIOR COLOUR	SIGNAL WHITE COLOUR TO SHADE NO. RAL9003
CUBICLE TYPE	VSH 200
FRAME	HINGED FRAME, MOVABLE
CUBICLE TYPE	FRONT ACCESS
MATERIAL OF CONSTRUCTION	ALUZINK STEEL
DIMENSIONS	2200 x 800 x 800 mm (H X W X D)
CLASS OF PROTECTION	IP 41
APPROX. WEIGHT	200KG
CABLE ENTRY	BOTTOM

AS-BUILT BY

DATE

CONTRACT NO. 11131113/00

JOB ORDER NO. S-13656

ASSEMBLY DRAWING

132KV BUSBAR PROTN.MAIN-1 BU PANEL +BBP1-5

S/S 8709 - 132/13.8KV IN AL-KHARJ CITY

RIYADH SAUDI ARABIA

نقل الكهرباء

الشركة الوطنية لنقل الكهرباء

National Grid sa

INDEX

PLANT NO.

DRAWING NUMBER

SHEET NO.

REV. NO.

01

13 49

FACTORY ASBUILT

00

13 05

FOR APPROVAL

REV. NO.

DATE

DESCRIPTION

OPRG. DEPT. CTPD

ENG. DEPT. AUT-PSAC

DRAWN BY RIZ

CHECKED BY KVR

DATE STARTED 28.01.2013


DATE COMPLETED

CD-322998

G01

G02

01

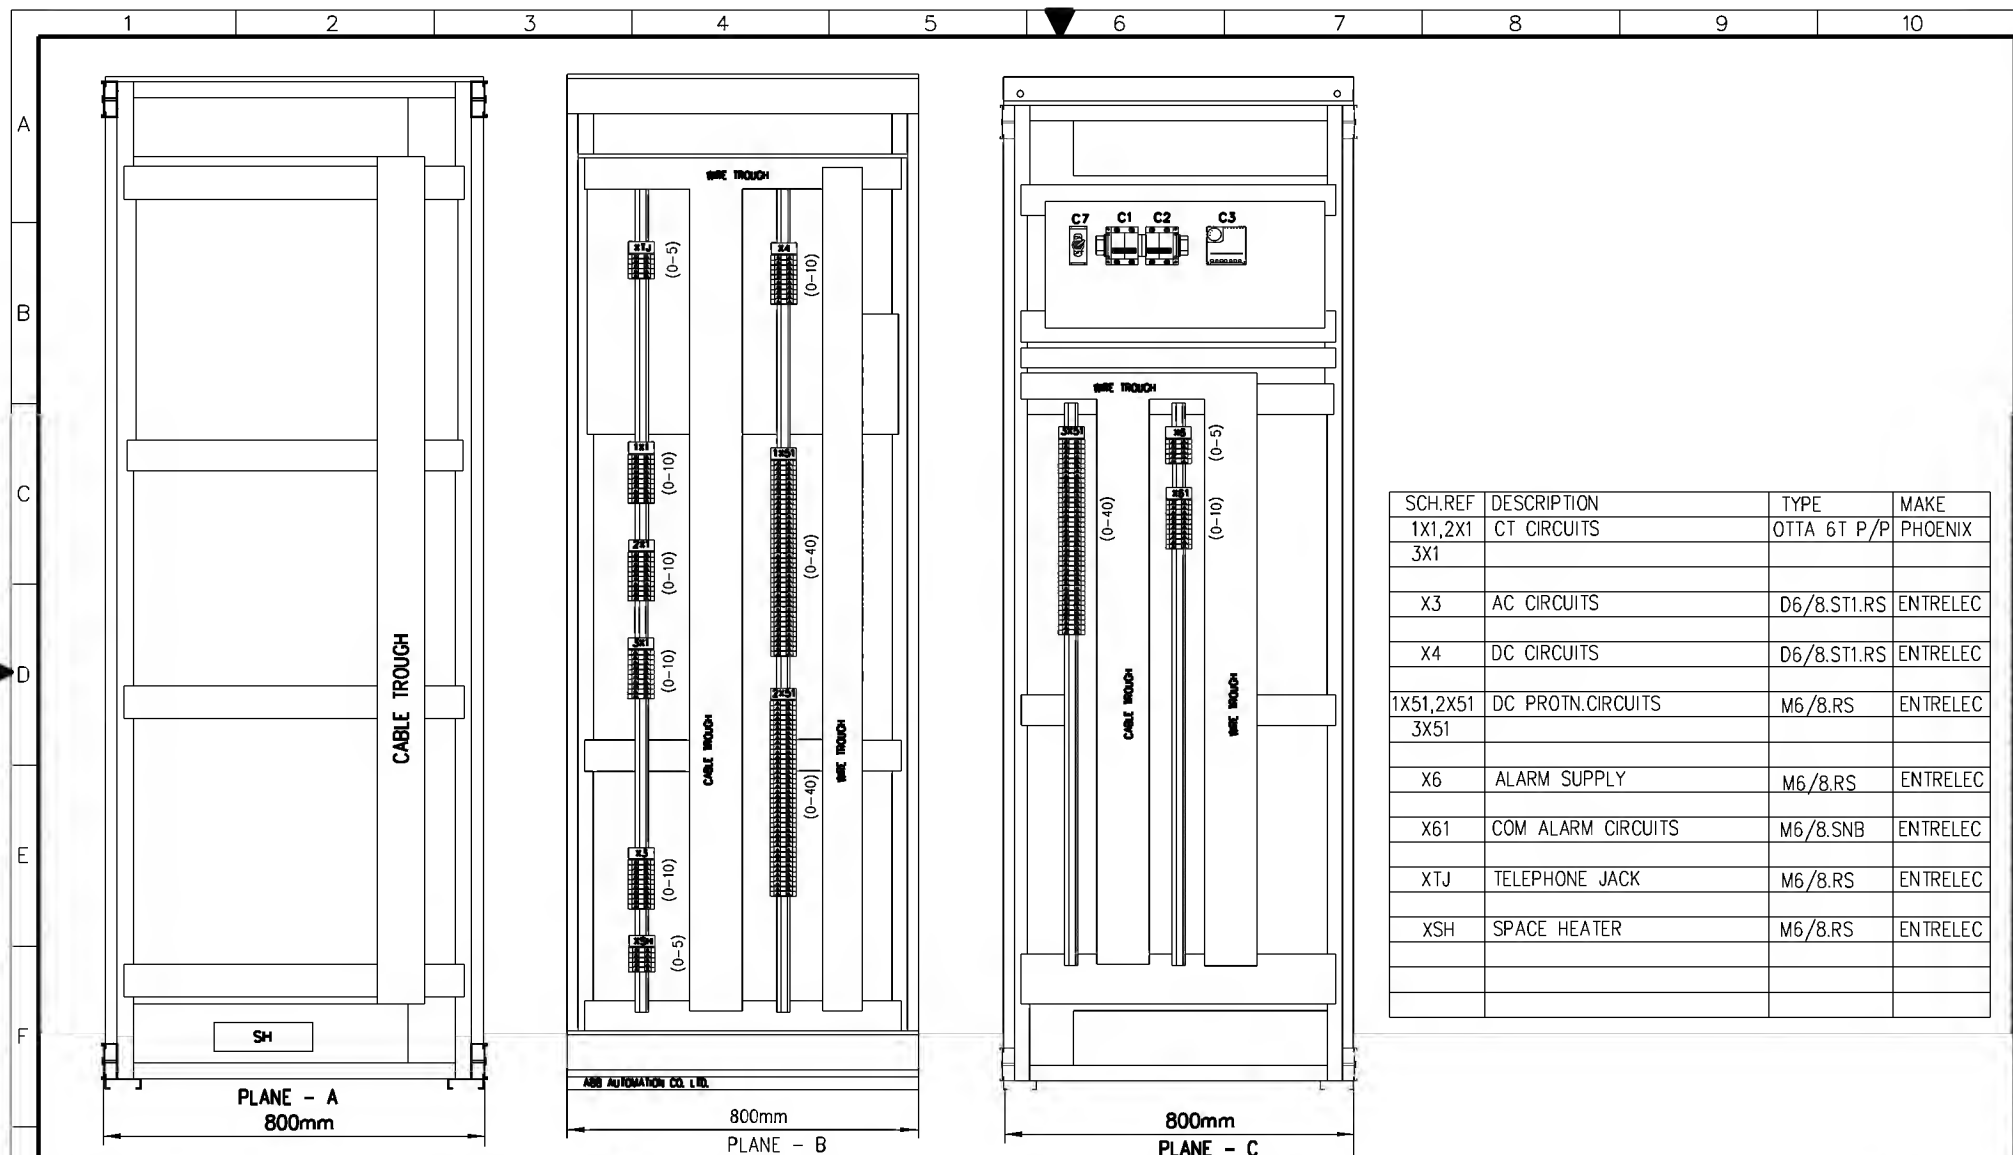

SCH.REF	DESCRIPTION	TYPE	MAKE
1X1,2X1 3X1	CT CIRCUITS	OTTA 6T P/P	PHOENIX
X3	AC CIRCUITS	D6/8.ST1.RS	ENTRELEC
X4	DC CIRCUITS	D6/8.ST1.RS	ENTRELEC
1X51,2X51 3X51	DC PROTN.CIRCUITS	M6/8.RS	ENTRELEC
X6	ALARM SUPPLY	M6/8.RS	ENTRELEC
X61	COM ALARM CIRCUITS	M6/8.SNB	ENTRELEC
XTJ	TELEPHONE JACK	M6/8.RS	ENTRELEC
XSH	SPACE HEATER	M6/8.RS	ENTRELEC

AS-BUILT BY _____ DATE _____ CONTRACT NO. **11131113/00** JOB ORDER NO. **S-13656**

01 **13 49** **FACTORY ASBUILT**
00 **13 05** **FOR APPROVAL**

DRAWN BY **RIZ** CHECKED BY **KVR**
DATE STARTED **28.01.2013** DATE COMPLETED _____
PRG. DEPT. **CTPD** ENG. DEPT. **AUT-PSAC**



ASSEMBLY DRAWING


132KV BUSBAR PROTN.MAIN-1 BU PANEL +8BP1-5
S/S 8709 - 132/13.8KV IN AL-KHARJ CITY
RIYADH SAUDI ARABIA


الشركة الوطنية لنقل الكهرباء



INDEX	PLANT NO.	DRAWING NUMBER	SHEET NO.	REV. NO.
-	C421	CD-322998	SHT CONT. G02 G03	01

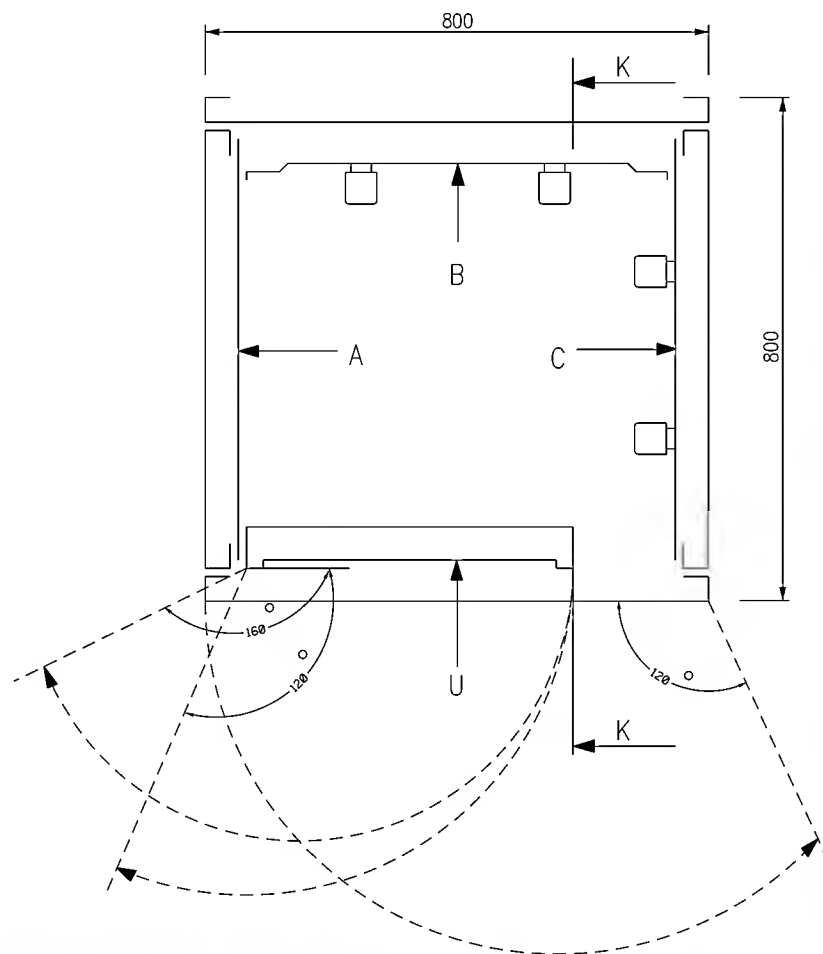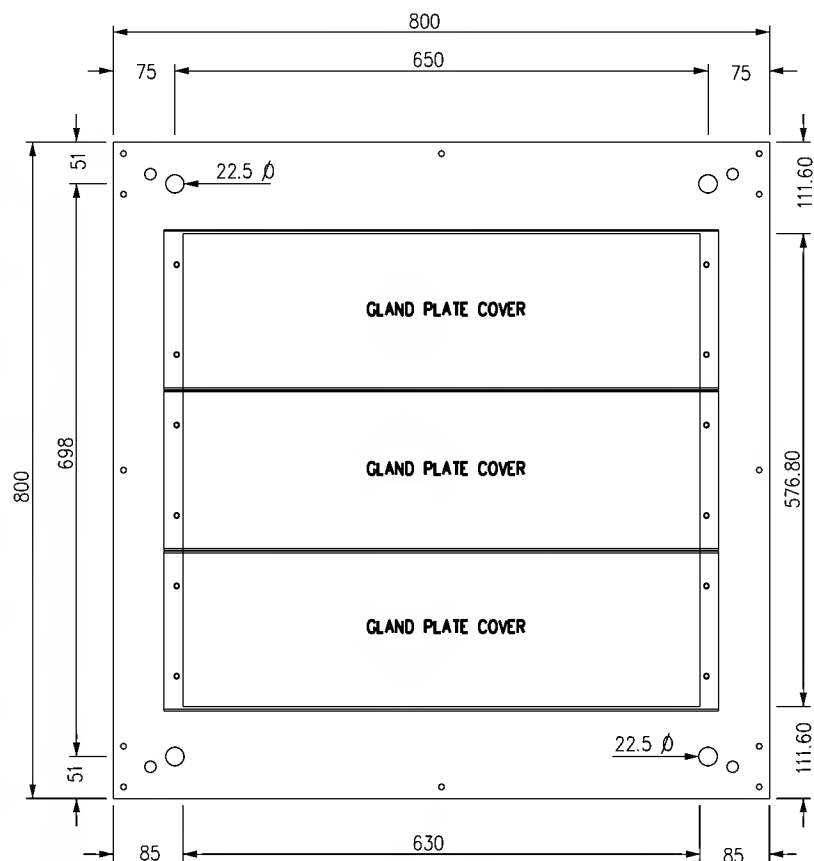

AS-BUILT BY _____ DATE _____			CONTRACT NO. 11131113/00		JOB ORDER NO. S-13656		ASSEMBLY DRAWING			<div>نقل الكهرباء</div> <div>الشركة الوطنية لنقل الكهرباء</div> <div>National Grid sa</div>				
DRAWN BY RIZ CHECKED BY KVR			132KV BUSBAR PROTN.MAIN-1 BU PANEL +8BP1-5			S/S 8709 - 132/13.8KV IN AL-KHARJ CITY			INDEX PLANT NO. DRAWING NUMBER SHEET NO. REV. NO.					
DATE STARTED 28.01.2013 DATE COMPLETED _____			S/5 8709 - 132/13.8KV IN AL-KHARJ CITY			RIYADH SAUDI ARABIA			- C421 CD-322998 G03 G04 01					
OPRG. DEPT. CTPD ENG. DEPT. AUT-PSAC														
FACTORY ASBUILT FOR APPROVAL														
REV. NO. DATE DESCRIPTION														

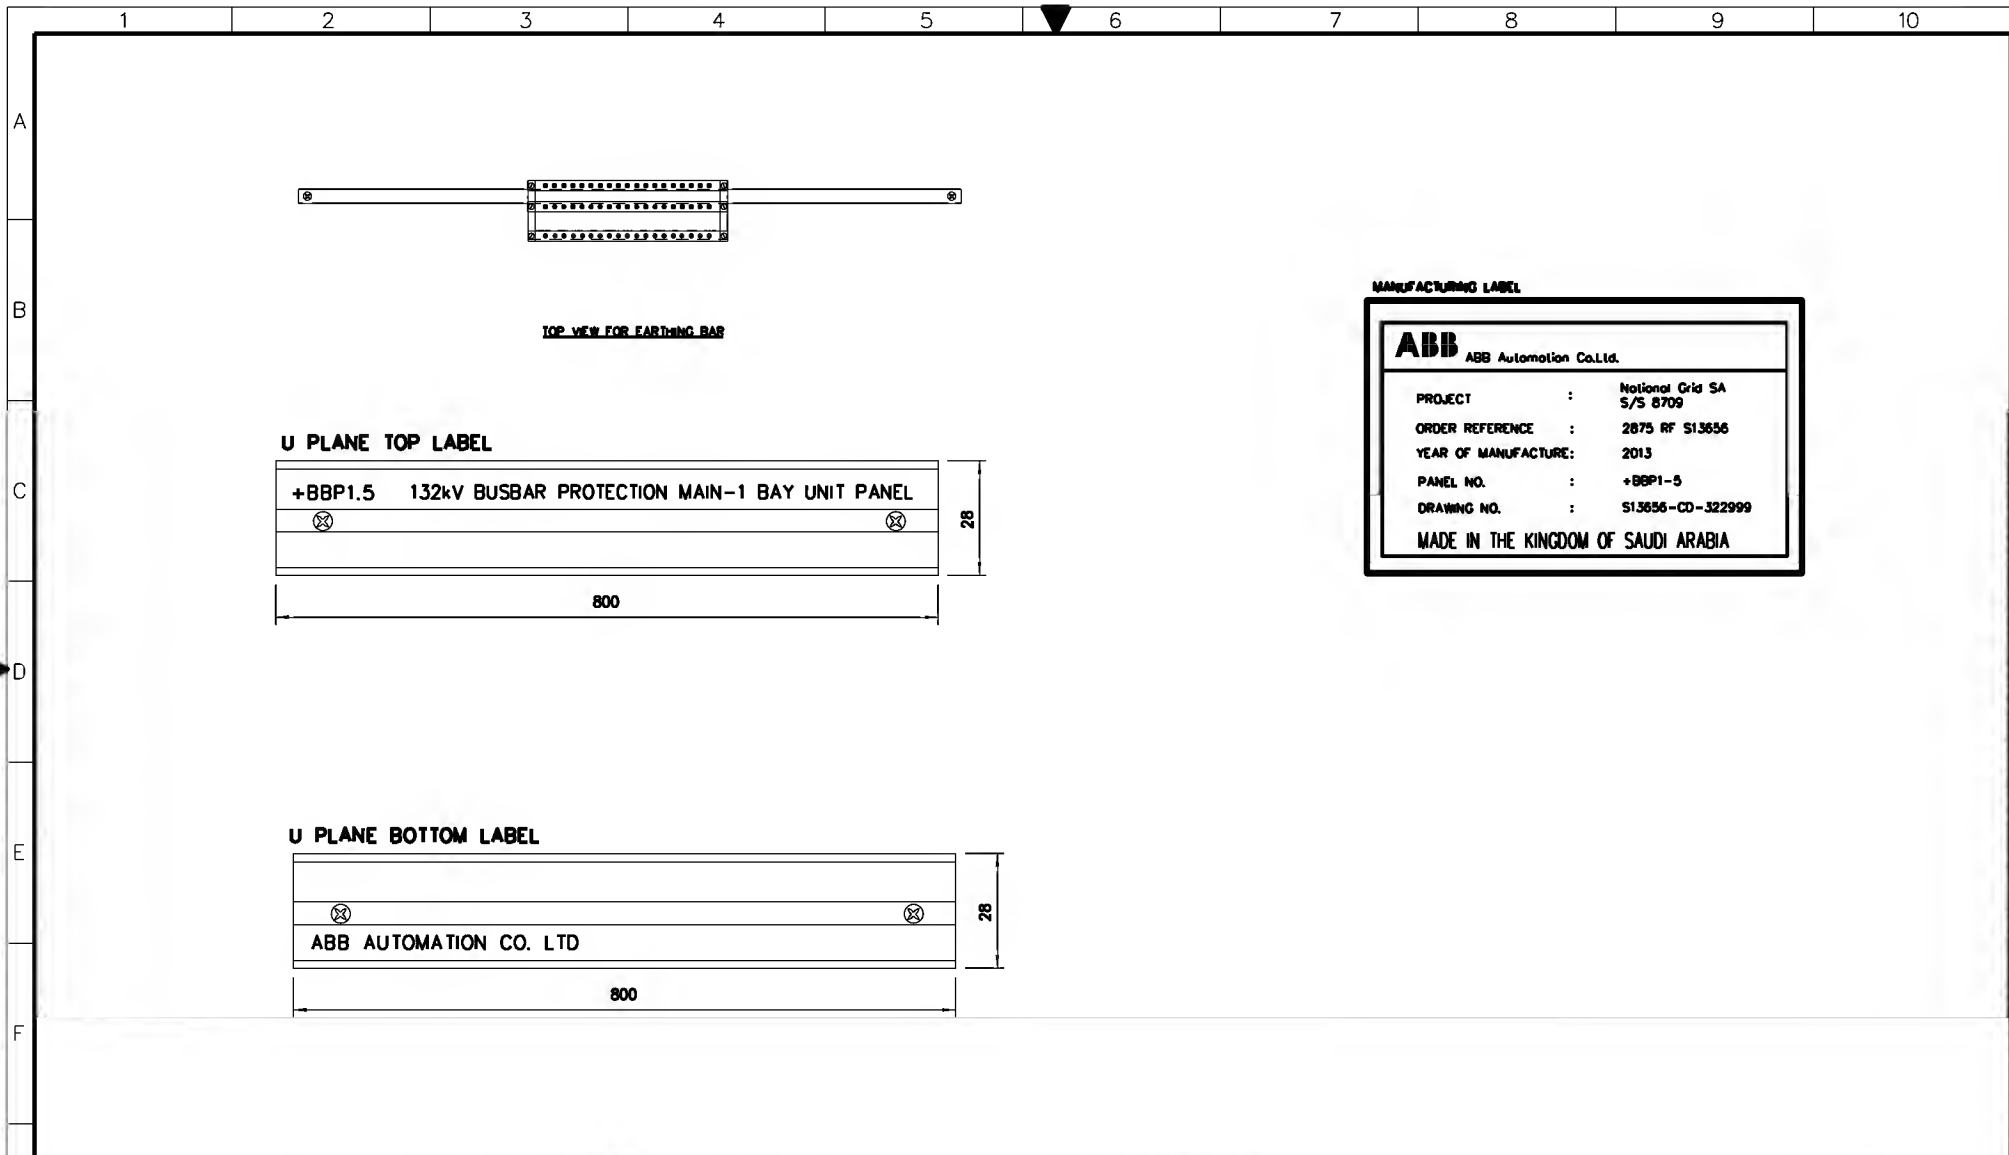

AS-BUILT BY _____ DATE _____			CONTRACT NO. 11131113/00		JOB ORDER NO. S-13656		ASSEMBLY DRAWING		الشركة الوطنية لنقل الكهرباء		نقل الكهرباء	
DRAWN BY RIZ CHECKED BY KVR			DATE STARTED 28.01.2013 DATE COMPLETED _____		132KV BUSBAR PROTN.MAIN-1 BU PANEL +BBP1-5		S/S 8709 - 132/13.8KV IN AL-KHARJ CITY		National Grid sa			
FOR APPROVAL			OPRG. DEPT. CTPD ENG. DEPT. AUT-PSAC		RIYADH		SAUDI ARABIA		INDEX		PLANT NO.	
REV. NO. 01			DATE 13 05		DESCRIPTION		FACTORY ASBUILT		DRAWING NUMBER		SHEET NO.	
									- C421		CD-322998	
									CONT.		REV. NO.	
									G04 L00		01	



POWER SYSTEMS NETWORK MANAGEMENT
PROTECTION AND SUBSTATION AUTOMATION SYSTEMS
WBS NO: S-13656


ABB AUTOMATION COMPANY LTD
414, AL-KHARJ ROAD
SECOND INDUSTRIAL CITY
RIYADH-11383 K.S.A

CONTRACTOR : ABB Contracting Company
CLIENT : National Gridsa
PROJECT : CONSTRUCTION OF NEW 132/13.8kV SS 8709 IN AL-KHARJ CITY
SUBSTATION : S/S 8709
CONTRACT NO. : 11131113/00
TITLE : LIST OF APPARATUS – +BBP1-5
[132KV BUSBAR PROTECTION MAIN-1 BAY UNIT PANEL]

AS-BUILT BY _____ DATE _____		CONTRACT NO. 11131113/00	JOB ORDER NO. S-13656	COVER SHEET		الشركة الوطنية لنقل الكهرباء		نقل الكهرباء	
01	13 49	FACTORY ASBUILT	DRAWN BY RIZ	CHECKED BY KVR	132KV BUSBAR PROTN.MAIN-1 BU PANEL +BBP1-5	National Grid sa			
00	13 05	FOR APPROVAL	DATE STARTED 28.01.2013	DATE COMPLETED	S/S 8709 - 132/13.8KV IN AL-KHARJ CITY	INDEX	PLANT NO.	DRAWING NUMBER	SHEET NO.
REV. NO.	DATE	DESCRIPTION	OPRG. DEPT. CTPD	ENG. DEPT. AUT-PSAC	RIYADH SAUDI ARABIA	-	C421	CD-322998	SH1 CONT.
									01

	2	3	4	5	6	7	8	9	10
--	---	---	---	---	---	---	---	---	----

[illegible]

AS-BUILT BY _____ DATE _____			CONTRACT NO. 11131113/00		JOB ORDER NO. S-13656		LIST OF APPARATUS 132KV BUSBAR PROT.N.MAIN-1 BU PANEL +BBP1-5 S/S 8709 - 132/13.8KV IN AL-KHARJ CITY RIYADH				نقل الكهرباء الشركة الوطنية لنقل الكهرباء  National Grid SA			
DRAWN BY RIZ CHECKED BY KVR			DATE STARTED 28.01.2013 DATE COMPLETED _____		OPRG. DEPT. CTPD ENG. DEPT. AUT-PSAC		132KV BUSBAR PROT.N.MAIN-1 BU PANEL +BBP1-5 S/S 8709 - 132/13.8KV IN AL-KHARJ CITY RIYADH				INDEX PLANT NO. DRAWING NUMBER SHEET NO. REV. NO. - C421 CD-322998 SHY CONT. 01			
01 13 49 FACTORY ASBUILT 00 13 05 FOR APPROVAL REV. NO. DATE DESCRIPTION							SAUDI ARABIA				01			

[illegible]

	2	3	4	5		6	7	8	9	10
--	---	---	---	---	---	---	---	---	---	----

[illegible]


AS-BUILT BY _____ DATE _____			CONTRACT NO. 11131113/00		JOB ORDER NO. S-13656		LIST OF APPARATUS 132KV BUSBAR PROTN.MAIN-1 BU PANEL +BBP1-5 S/S 8709 - 132/13.8KV IN AL-KHARJ CITY RIYADH SAUDI ARABIA			نقل الكهرباء الشركة الوطنية لنقل الكهرباء National Grid SA				
DRAWN BY RIZ CHECKED BY KVR DATE STARTED 28.01.2013 DATE COMPLETED _____ OPRG. DEPT. CTPD ENG. DEPT. AUT-PSAC									INDEX PLANT NO. DRAWING NUMBER SHEET NO. REV. NO. - C421 CD-322998 103104 01					
01 13 49 FACTORY ASBUILT 00 13 05 FOR APPROVAL REV. NO. DATE DESCRIPTION														

LABEL REF.	LABEL ENGRAVING	MATERIALS	ENGRAVING	LABEL SIZE	LETTER SIZE
U08.5001	U08.5001 878+508F-1/BU-D02	TRAFOLITE	BLACK LETTERS ON WHITE BACKGROUND	50X15mm	4mm
U08.5002	U08.5002 878+508F-1/BU-D04	TRAFOLITE	BLACK LETTERS ON WHITE BACKGROUND	50X15mm	4mm
U15.5001	U15.5001 878+508F-1/BU-D06	TRAFOLITE	BLACK LETTERS ON WHITE BACKGROUND	50X15mm	4mm
U22.5001	U22.5001 IS-1	ALUMINUM PAPER FOIL	BLACK LETTERS	50X10mm	3mm
U22.5002	U22.5002 IS-2	ALUMINUM PAPER FOIL	BLACK LETTERS	50X10mm	3mm
U22.5003	U22.5003 IS-3	ALUMINUM PAPER FOIL	BLACK LETTERS	50X10mm	3mm
U26.101	U26.101 748F-1/D02	ALUMINUM PAPER FOIL	BLACK LETTERS	50X10mm	3mm
U26.301	U26.301 748F-1/D06	ALUMINUM PAPER FOIL	BLACK LETTERS	50X10mm	3mm
U37.5001	U37.5001 DC SUPPLY MCB FOR D02	TRAFOLITE	BLACK LETTERS ON WHITE BACKGROUND	50X15mm	4mm
U37.5002	U37.5002 DC SUPPLY MCB FOR D04	TRAFOLITE	BLACK LETTERS ON WHITE BACKGROUND	50X15mm	4mm
U37.5003	U37.5003 DC SUPPLY MCB FOR D06	TRAFOLITE	BLACK LETTERS ON WHITE BACKGROUND	50X15mm	4mm
U37.5004	U37.5004 C01-127V,C02-220V	TRAFOLITE	BLACK LETTERS ON WHITE BACKGROUND	50X15mm	4mm
U37.5005	U37.5005 UJ	TRAFOLITE	BLACK LETTERS ON WHITE BACKGROUND	50X15mm	4mm

AS-BUILT BY _____ DATE _____			CONTRACT NO. 1113113/00		JOB ORDER NO. S-13656		LIST OF APPARATUS		نقل الكهرباء الشركة الوطنية لنقل الكهرباء National Grid sa	
01 13 49 00 13 05 FACTORY ASBUILT FOR APPROVAL			DRAWN BY RIZ CHECKED BY KVR DATE STARTED 28.01.2013 DATE COMPLETED _____ OPRG. DEPT. CTPD ENG. DEPT. AUT-PSAC		132KV BUSBAR PROTN.MAIN-1 BU PANEL +88P1-5 S/S 8709 - 132/13.8KV IN AL-KHARJ CITY RIYADH SAUDI ARABIA			INDEX PLANT NO. DRAWING NUMBER SHEET NO. REV. NO. - C421 CD-322998 L06L07 01		

	1	2	3	4	5	6	7	8	9	10
A										
B										
C										
D										
E										
F										
G										

LABEL REF.	LABEL ENGRAVING	MATERIALS	ENGRAVING	LABEL SIZE	LETTER SIZE
C1	C1 127V AC SUPPLY MCB	TRAFOLITE	BLACK LETTERS ON WHITE BACKGROUND	50X15mm	4mm
C2	C2 220V AC SUPPLY MCB	TRAFOLITE	BLACK LETTERS ON WHITE BACKGROUND	50X15mm	4mm
C3	C3 THERMOSTAT	TRAFOLITE	BLACK LETTERS ON WHITE BACKGROUND	50X15mm	4mm
C7	C7 ON/OFF SWITCH	TRAFOLITE	BLACK LETTERS ON WHITE BACKGROUND	50X15mm	4mm
DS	DS DOOR SWITCH	TRAFOLITE	BLACK LETTERS ON WHITE BACKGROUND	50X15mm	4mm
IL	IL ILLUMINATION LAMP	TRAFOLITE	BLACK LETTERS ON WHITE BACKGROUND	50X15mm	4mm
SH	SH SPACE HEATER	TRAFOLITE	BLACK LETTERS ON WHITE BACKGROUND	50X15mm	4mm

AS-BUILT BY _____ DATE _____			CONTRACT NO. 11131113/00		JOB ORDER NO. S-13656		LIST OF APPARATUS 132KV BUSBAR PROTN.MAIN-1 BU PANEL +8BP1-5 S/S 8709 - 132/13.8KV IN AL-KHARJ CITY RIYADH SAUDI ARABIA		الشركة الوطنية لنقل الكهرباء  نقل الكهرباء National Grid sa				
01	13 49	FACTORY ASBUILT	DRAWN BY RIZ CHECKED BY KVR						INDEX	PLANT NO.	DRAWING NUMBER	SHEET NO.	REV. NO.
00	13 05	FOR APPROVAL	DATE STARTED 28.01.2013 DATE COMPLETED _____						-	C421	CD-322998	SHT CONT.	01
REV. NO.	DATE	DESCRIPTION	OPRG. DEPT. CTPD ENG. DEPT. AUT-PSAC									L06NIL	

THIS DRAWING AND THE INFORMATION CONTAINED HEREIN ARE THE SOLE PROPERTY OF NATIONAL GRID SA. NO REPRODUCTION OR TRANSMISSION IN ANY FORM OR BY ANY MEANS, WITHOUT THE WRITTEN CONSENT OF ITS OWNER.



POWER SYSTEMS NETWORK MANAGEMENT
PROTECTION AND SUBSTATION AUTOMATION SYSTEMS
WBS NO: S-13656

ABB AUTOMATION COMPANY LTD.
414, AL-KHARJ ROAD
SECOND INDUSTRIAL CITY
RIYADH-11383 K.S.A

CONTRACTOR : ABB Contracting Company
CLIENT : National Gridsa
PROJECT : CONSTRUCTION OF NEW 132/13.8kV SS 8709 IN AL-KHARJ CITY
SUBSTATION : S/S 8709
CONTRACT NO. : 11131113/00
TITLE : SCHEMATICS DRAWINGS – +BBP1-5
[132KV BUSBAR PROTECTION MAIN-1 BAY UNIT PANEL]

AS-BUILT BY _____ DATE _____		CONTRACT NO. 11131113/00	JOB ORDER NO. S-13656	COVER SHEET		الشركة الوطنية لنقل الكهرباء National Grid sa				
01	13 49	FACTORY ASBUILT	DRAWN BY RIZ	CHECKED BY KVR	132KV BUSBAR PROTN.MAIN-1 BU PANEL +BBP1-5	INDEX	PLANT NO.	DRAWING NUMBER	SHEET NO.	REV. NO.
00	13 05	FOR APPROVAL	DATE STARTED 28.01.2013	DATE COMPLETED _____	S/S 8709 - 132/13.8KV IN AL-KHARJ CITY	-	C421	CD-322999	SHT CONT.	01
REV. NO.	DATE	DESCRIPTION	OPRG. DEPT. CTPD	ENG. DEPT. AUT-PSAC	RIYADH SAUDI ARABIA					

1

2

3

4

5

6

7

8

9

10

A

B

C

D

E

F

SYMBOL	DESCRIPTION	SYMBOL	DESCRIPTION	SYMBOL	DESCRIPTION
	FRAME CONNECTION		MAIN CONTACT OF A CIRCUIT BREAKER PASSING MAKE CONTACT CLOSING MOMENTARILY DURING OPERATION AND RELEASE		RELAY WITH TWO MAKE CONTACTS, ONE OF THEM DELAYED WHEN OPERATING
	EARTH CONNECTION		BREAK CONTACT DELAYED WHEN OPERATING		RELAY WITH TWO ACTUATORS AND A TWO STABLE POSITIONS
	RESISTOR		MAKE CONTACT DELAYED WHEN RELEASING		
	VARIABLE RESISTOR		TWO MECHANICAL LINKS CROSSING WITHOUT CONNECTION		SIGNALLING LAMP
	RESISTOR WITH PRESET ADJUSTMENT		JUNCTION OF MECHANICAL LINKS		MECHANICAL INDICATOR WITH AUTOMATIC RESET
	CAPACITOR		AUTOMATIC RESET		MECHANICAL INDICATOR WITH NON-AUTOMATIC RESET
	SEMICONDUCTOR DIODE USED AS A CAPACITIVE DEVICE		NON-AUTOMATIC RESET		ELECTRICALLY CONTROLLED MECHANICAL INDICATOR WITH AUTOMATIC RESET
	OPEN CONTACT, MAKE CONTACT		SWITCHING DEVICE WITH MANUAL OPERATION AND WITH AUTOMATIC RESET		ELECTRICALLY CONTROLLED MECHANICAL INDICATOR WITH NON-AUTOMATIC RESET
	CLOSED CONTACT, BREAK CONTACT		SWITCHING DEVICE WITH MANUAL OPERATION AND WITH NON-AUTOMATIC RESET		RELAY WITH MECHANICAL INDICATOR
	CHANGE-OVER CONTACT, BREAK BEFORE MAKE		CHANGE-OVER SWITCHING DEVICE WITH MANUAL CONTROL AUTOMATIC RESET FROM POSITION 1-2 TO THE NEUTRAL POSITION		ELECTRO-MECHANICAL POSITION INDICATOR WITH ONE DE-ENERGIZED AND ONE OPERATED POSITION
	MAKE CONTACT WHICH IS EARLY WHEN OPERATING AND LATE WHEN RELEASING		RELAY WITH MAKE CONTACT		ELECTRO-MECHANICAL POSITION INDICATOR WITH ONE DE-ENERGIZED AND TWO OPERATED POSITION
	BREAK CONTACT WHICH IS LATE WHEN OPERATING AND EARLY WHEN RELEASING		RELAY WITH CHANGE-OVER CONTACT		BELL, BUZZER
	SWITCHING DEVICE WITH MANUAL CONTROL		RELAY WITH MAKE CONTACT, DELAYED WHEN OPERATING		SIREN , HORN
	MAKE CONTACT DELAYED WHEN OPERATING		RELAY WITH MAKE CONTACT, DELAYED WHEN RELEASING		
	BREAK CONTACT DELAYED WHEN RELEASING		RELAY WITH MAKE CONTACT, DELAYED WHEN OPERATING AND RELEASING		
	MAKE CONTACT DELAYED WHEN OPERATING AND RELEASING				
	MAIN CONTACT OF A SWITCH DISCONNECTOR				
	MAIN CONTACT OF A DISCONNECTOR				

AS-BUILT BY _____ DATE _____		CONTRACT NO. 11131113/00		JOB ORDER NO. S-13656		GRAPHICAL SYMBOLS FOR DIAGRAMS		الشركة الوطنية لنقل الكهرباء		نقل الكهرباء	
DRAWN BY RIZ		CHECKED BY KVR		132KV BUSBAR PROTN.MAIN-1 BU PANEL +8BP1-5		S/S 8709 - 132/13.8KV IN AL-KHARJ CITY		INDEX		PLANT NO.	
DATE STARTED 28.01.2013		DATE COMPLETED _____		RIYADH		SAUDI ARABIA		DRAWING NUMBER		SHEET NO.	
PRG. DEPT. CTPD		ENG. DEPT. AUT-PSAC		-		C421		CD-322999		REV. NO.	
REV. NO.		DATE		DESCRIPTION		01		012		01	
01		13 49		FACTORY ASBUILT							
00		13 05		FOR APPROVAL							

1	2	3	4	5	6	7	8	9	10																																																																																																						
A																																																																																																															
B																																																																																																															
C																																																																																																															
D																																																																																																															
E																																																																																																															
F																																																																																																															
<table><tr><th>SYMBOL</th><th>DESCRIPTION</th><th>SYMBOL</th><th>DESCRIPTION</th><th>SYMBOL</th><th>DESCRIPTION</th></tr><tr><td></td><td>FUSE / LINK</td><td></td><td>WATTMETER</td><td></td><td>ELEMENT WITH NEGATED INHIBITING INPUT</td></tr><tr><td></td><td>FUSE WITH THE SUPPLY SIDE INDICATED</td><td></td><td>VARMETER</td><td></td><td>ELEMENT WITH INPUT WHICH DOES NOT CARRY ANY LOGIC INFORMATION</td></tr><tr><td></td><td>SINGLE-PHASE TRANSFORMER WITH TWO SEPARATE WINDINGS (TWO ALTERNATIVE FORMS)</td><td></td><td>POWER FACTOR METER</td><td></td><td>ELEMENT WITH POSTPONED OUTPUT</td></tr><tr><td></td><td>SINGLE-PHASE TRANSFORMER WITH TWO SEPARATE WINDINGS (TWO ALTERNATIVE FORMS)</td><td></td><td>POSITION INDICATOR</td><td></td><td>AND-ELEMENT WITH TWO INPUTS</td></tr><tr><td></td><td>SINGLE-PHASE TRANSFORMER WITH FERRO MAGNETIC CORE</td><td></td><td>SYNCHROSCOPE</td><td></td><td>OR-ELEMENT WITH TWO INPUTS</td></tr><tr><td></td><td>SINGLE-PHASE VOLTAGE TRANSFORMER (MULTI-LINE AND SINGLE-LINE REPRESENTATION)</td><td></td><td>RECORDING VOLTMETER</td><td></td><td>LOGIC THRESHOLD ELEMENT WITH FOUR INPUTS AND THRESHOLD VALUE 2</td></tr><tr><td></td><td>SINGLE-PHASE VOLTAGE TRANSFORMER WITH TWO SECONDARY WINDINGS (MULTI-LINE AND SINGLE-LINE REPRESENTATION)</td><td></td><td>RECORDING WATTMETER</td><td></td><td>ELEMENT WITH THREE INPUTS FOR "2 AND ONLY 2"</td></tr><tr><td></td><td>CURRENT TRANSFORMER (MULTI-LINE AND SINGLE-LINE REPRESENTATION)</td><td></td><td>HOUR METER</td><td></td><td>EXCLUSIVE OR-ELEMENT WITH THREE INPUTS</td></tr><tr><td></td><td>CURRENT TRANSFORMER WITH TWO CORES (MULTI-LINE AND SINGLE-LINE REPRESENTATION)</td><td></td><td>WATT-HOUR METER</td><td></td><td>LOGIC IDENTITY ELEMENT WITH THREE INPUTS</td></tr><tr><td></td><td>CURRENT TRANSFORMER WITH TWO SECONDARY WINDINGS ON ONE CORE (MULTI-LINE AND SINGLE-LINE REPRESENTATION)</td><td></td><td>WATT-HOUR METER FOR ENERGY FROM A BUSBAR SYSTEM</td><td></td><td>MAJORITY ELEMENT WITH THREE INPUTS</td></tr><tr><td></td><td>FILTER</td><td></td><td>ELEMENT WITH STATIC INPUT</td><td></td><td>NEGATOR</td></tr><tr><td></td><td>HIGH-PASS FILTER</td><td></td><td>ELEMENT WITH STATIC NEGATED INPUT</td><td></td><td>NAND ELEMENT WITH TWO INPUTS</td></tr><tr><td></td><td>BAND-PASS FILTER</td><td></td><td>ELEMENT WITH STATIC NEGATED OUTPUT</td><td></td><td>NOR ELEMENT WITH TWO INPUTS</td></tr><tr><td></td><td>VOLTMETER</td><td></td><td>ELEMENT WITH DYNAMIC INPUT</td><td></td><td>BISTABLE ELEMENT</td></tr><tr><td></td><td>AMMETER</td><td></td><td>ELEMENT WITH DYNAMIC NEGATED INPUT</td><td></td><td></td></tr><tr><td></td><td></td><td></td><td>ELEMENT WITH INHIBITING INPUT</td><td></td><td></td></tr></table>										SYMBOL	DESCRIPTION	SYMBOL	DESCRIPTION	SYMBOL	DESCRIPTION		FUSE / LINK		WATTMETER		ELEMENT WITH NEGATED INHIBITING INPUT		FUSE WITH THE SUPPLY SIDE INDICATED		VARMETER		ELEMENT WITH INPUT WHICH DOES NOT CARRY ANY LOGIC INFORMATION		SINGLE-PHASE TRANSFORMER WITH TWO SEPARATE WINDINGS (TWO ALTERNATIVE FORMS)		POWER FACTOR METER		ELEMENT WITH POSTPONED OUTPUT		SINGLE-PHASE TRANSFORMER WITH TWO SEPARATE WINDINGS (TWO ALTERNATIVE FORMS)		POSITION INDICATOR		AND-ELEMENT WITH TWO INPUTS		SINGLE-PHASE TRANSFORMER WITH FERRO MAGNETIC CORE		SYNCHROSCOPE		OR-ELEMENT WITH TWO INPUTS		SINGLE-PHASE VOLTAGE TRANSFORMER (MULTI-LINE AND SINGLE-LINE REPRESENTATION)		RECORDING VOLTMETER		LOGIC THRESHOLD ELEMENT WITH FOUR INPUTS AND THRESHOLD VALUE 2		SINGLE-PHASE VOLTAGE TRANSFORMER WITH TWO SECONDARY WINDINGS (MULTI-LINE AND SINGLE-LINE REPRESENTATION)		RECORDING WATTMETER		ELEMENT WITH THREE INPUTS FOR "2 AND ONLY 2"		CURRENT TRANSFORMER (MULTI-LINE AND SINGLE-LINE REPRESENTATION)		HOUR METER		EXCLUSIVE OR-ELEMENT WITH THREE INPUTS		CURRENT TRANSFORMER WITH TWO CORES (MULTI-LINE AND SINGLE-LINE REPRESENTATION)		WATT-HOUR METER		LOGIC IDENTITY ELEMENT WITH THREE INPUTS		CURRENT TRANSFORMER WITH TWO SECONDARY WINDINGS ON ONE CORE (MULTI-LINE AND SINGLE-LINE REPRESENTATION)		WATT-HOUR METER FOR ENERGY FROM A BUSBAR SYSTEM		MAJORITY ELEMENT WITH THREE INPUTS		FILTER		ELEMENT WITH STATIC INPUT		NEGATOR		HIGH-PASS FILTER		ELEMENT WITH STATIC NEGATED INPUT		NAND ELEMENT WITH TWO INPUTS		BAND-PASS FILTER		ELEMENT WITH STATIC NEGATED OUTPUT		NOR ELEMENT WITH TWO INPUTS		VOLTMETER		ELEMENT WITH DYNAMIC INPUT		BISTABLE ELEMENT		AMMETER		ELEMENT WITH DYNAMIC NEGATED INPUT						ELEMENT WITH INHIBITING INPUT		
SYMBOL	DESCRIPTION	SYMBOL	DESCRIPTION	SYMBOL	DESCRIPTION																																																																																																										
	FUSE / LINK		WATTMETER		ELEMENT WITH NEGATED INHIBITING INPUT																																																																																																										
	FUSE WITH THE SUPPLY SIDE INDICATED		VARMETER		ELEMENT WITH INPUT WHICH DOES NOT CARRY ANY LOGIC INFORMATION																																																																																																										
	SINGLE-PHASE TRANSFORMER WITH TWO SEPARATE WINDINGS (TWO ALTERNATIVE FORMS)		POWER FACTOR METER		ELEMENT WITH POSTPONED OUTPUT																																																																																																										
	SINGLE-PHASE TRANSFORMER WITH TWO SEPARATE WINDINGS (TWO ALTERNATIVE FORMS)		POSITION INDICATOR		AND-ELEMENT WITH TWO INPUTS																																																																																																										
	SINGLE-PHASE TRANSFORMER WITH FERRO MAGNETIC CORE		SYNCHROSCOPE		OR-ELEMENT WITH TWO INPUTS																																																																																																										
	SINGLE-PHASE VOLTAGE TRANSFORMER (MULTI-LINE AND SINGLE-LINE REPRESENTATION)		RECORDING VOLTMETER		LOGIC THRESHOLD ELEMENT WITH FOUR INPUTS AND THRESHOLD VALUE 2																																																																																																										
	SINGLE-PHASE VOLTAGE TRANSFORMER WITH TWO SECONDARY WINDINGS (MULTI-LINE AND SINGLE-LINE REPRESENTATION)		RECORDING WATTMETER		ELEMENT WITH THREE INPUTS FOR "2 AND ONLY 2"																																																																																																										
	CURRENT TRANSFORMER (MULTI-LINE AND SINGLE-LINE REPRESENTATION)		HOUR METER		EXCLUSIVE OR-ELEMENT WITH THREE INPUTS																																																																																																										
	CURRENT TRANSFORMER WITH TWO CORES (MULTI-LINE AND SINGLE-LINE REPRESENTATION)		WATT-HOUR METER		LOGIC IDENTITY ELEMENT WITH THREE INPUTS																																																																																																										
	CURRENT TRANSFORMER WITH TWO SECONDARY WINDINGS ON ONE CORE (MULTI-LINE AND SINGLE-LINE REPRESENTATION)		WATT-HOUR METER FOR ENERGY FROM A BUSBAR SYSTEM		MAJORITY ELEMENT WITH THREE INPUTS																																																																																																										
	FILTER		ELEMENT WITH STATIC INPUT		NEGATOR																																																																																																										
	HIGH-PASS FILTER		ELEMENT WITH STATIC NEGATED INPUT		NAND ELEMENT WITH TWO INPUTS																																																																																																										
	BAND-PASS FILTER		ELEMENT WITH STATIC NEGATED OUTPUT		NOR ELEMENT WITH TWO INPUTS																																																																																																										
	VOLTMETER		ELEMENT WITH DYNAMIC INPUT		BISTABLE ELEMENT																																																																																																										
	AMMETER		ELEMENT WITH DYNAMIC NEGATED INPUT																																																																																																												
			ELEMENT WITH INHIBITING INPUT																																																																																																												

AS-BUILT BY _____ DATE _____			CONTRACT NO. 11131113/00		JOB ORDER NO. S-13656		GRAPHICAL SYMBOLS FOR DIAGRAMS			نقل الكهرباء		
DRAWN BY RIZ CHECKED BY KVR			132KV BUSBAR PROTN.MAIN-1 BU PANEL +BBP1-5			الشركة الوطنية لنقل الكهرباء			National Grid sa			
DATE STARTED 28.01.2013 DATE COMPLETED _____			S/S 8709 - 132/13.8KV IN AL-KHARJ CITY			INDEX	PLANT NO.	DRAWING NUMBER	SHEET NO.	REV. NO.		
PRG. DEPT. CTPD ENG. DEPT. AUT-PSAC			RIYADH SAUDI ARABIA			-	C421	CD-322999	012 013	01		
REV. NO.	DATE	DESCRIPTION										
01	13 49	FACTORY ASBUILT										
00	13 05	FOR APPROVAL										

LEGENDS

±R1	DC SUPPLY - MAIN PROTECTION
±R2	DC SUPPLY - SECONDARY PROTECTION
±R3	DC SUPPLY - BACK UP PROTECTION
±IT	DC SUPPLY - INTER TRIP
FL	DC SUPPLY - FLASHING CIRCUIT
BB RS±	DC SUPPLY - BUS BAR - PROTECTION RESET
BB CBF±/CBF±	DC SUPPLY - CBF PROTECTION
R	RESET BUS - ALARM SYSTEM
CR	CONTROL ROOM
ECC	ENERGY CONTROL CENTRE
LOCAL	THE LOCATION OF CONTROLLED DEVICE
REMOTE	ANY OTHER LOCATION NOT LOCAL
ON	CB NORMALLY OPEN AUXILIARY CONTACT
OFF	CB NORMALLY CLOSED AUXILIARY CONTACT
A	COMMON
T	TEST POSITION
S	SERVICE POSITION
CS	CLOSE IN SERVICE POSITION
CT	CLOSE IN TEST POSITION
LS	LOCAL SERVICE
LT	LOCAL TEST
LC	LOCAL CLOSE
LO	LOCAL OPEN
RO	REMOTE OPEN
OP	OPERATE
RE	RESET

NOTES

LABELS

WHITE LABEL WITH BLACK LETTERING WILL BE PROVIDED FOR ALL MOUNTED APPARATUS EQUIPMENT IDENTIFICATION AND FUNCTION REFERENCE LABEL WILL BE PROVIDED FOR FRONT MOUNTED EQUIPMENTS OF THE PANEL AND EQUIPMENT IDENTIFICATION LABEL WILL BE PROVIDED FOR INTERNALLY MOUNTED EQUIPMENTS

WIRING

PVC INSULATED 600V GRADE
 2.5 SQ.mm. YELLOW COLOURED FOR CT CIRCUITS
 2.5 SQ.mm. RE COLOURED FOR VT CIRCUITS
 1.5 SQ.mm. GREY COLOURED FOR DC SUPPLY, SCADA AND CONTROL CIRCUITS
 2.5 SQ.mm. BLACK COLOURED FOR AVC AND AC CIRCUITS
 2.5 SQ.mm. YELLOW/GREEN COLOURED FOR EARTHING CONNECTIONS
 FOLLOWING MARKERS SHALL BE PROVIDED ON FOLLOWING WIRES:
 + SIGN FOR DC + WIRE
 - SIGN FOR DC - WIRE

LUGS


A. CT CIRCUITS- RING TYPE
 B. OTHER CIRCUITS - SPADE TYPE

FERULLING

YELLOW TUBE 3.2 mm FOR 1.5SQ mm WIRES AND 4.2 FOR 2.5 SQ mm WIRES
 (AS PER 31 - TMSS-1, RE.0)


AS-BUILT BY _____ DATE _____		CONTRACT NO. 11131113/00		JOB ORDER NO. S-13656		COMMON LEGEND		الشركة الوطنية لنقل الكهرباء		نقل الكهرباء	
DRAWN BY RIZ CHECKED BY KVR		DATE STARTED 28.01.2013 DATE COMPLETED _____		132KV BUSBAR PROT.N.MAIN-1 BU PANEL +BBP1-5		S/S 8709 - 132/13.8KV IN AL-KHARJ CITY		INDEX		PLANT NO.	
PRG. DEPT. CTPD ENG. DEPT. AUT-PSAC		RIYADH		SAUDI ARABIA		DRAWING NUMBER		SHEET NO.		REV. NO.	
REV. NO.		DATE		DESCRIPTION		- C421		CD-322999		013 014 01	
01 13 49		FACTORY ASBUILT									
00 13 05		FOR APPROVAL									

FOR 132kV RELAY & CONTROL, PROT. PANELS

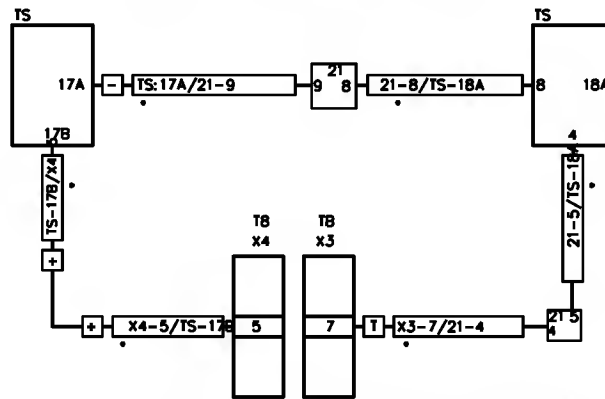

AS PER IEC-391 FIG 14a (W/O SUPPLEMENTARY/IDENTIFICATION MARK)

FOR 132kV PANELS INTERPANEL WIRING

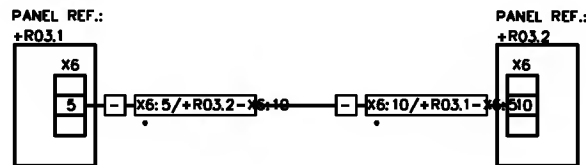

AS PER IEC-391 FIG 14d (W/O SUPPLEMENTARY/IDENTIFICATION MARK)

WIRES -
PVC insulated, stranded,
coiled annealed copper
conductor graded for 1000V

a. CT Circuits - 2.5 Sqmm PVC Yellow colour

b. VT Circuits - 1.5 Sqmm PVC Red colour

c. DC, & CONTROL Circuits - 1.5 Sqmm
PVC Grey colour

d. Alarm Circuits - 1.0 Sqmm PVC Blue colour

e. AVC & AC Circuits - 2.5 Sqmm PVC Black colour

f. Earth Circuits - 2.5 Sqmm PVC Yellow/Green colour

LUGS -
Pre-insulated

a) CT Circuits - Ring type

b) Other Circuits - Spode type

- NOTE:1 ADDITIONAL MARKING AS APPLICABLE
NOTE:2 FERRULE NUMBERING WILL BE BLACK
LETTERS ON YELLOW TUBE
3.2 mm for 1.5 sq mm wires and
4.2 mm for 2.5 sq mm wires
(As per 31-TWSS-1, REV 0)
NOTE:3 STARTING POINT OF THE
FERRULE LEFT TO RIGHT

AS-BUILT BY _____ DATE _____ CONTRACT NO. 11131113/00 JOB ORDER NO. S-13656

01	13 49	FACTORY ASBUILT
00	13 05	FOR APPROVAL
REV. NO.	DATE	DESCRIPTION

DRAWN BY RIZ CHECKED BY KVR
DATE STARTED 28.01.2013 DATE COMPLETED _____
OPRG. DEPT. CTPD ENG. DEPT. AUT-PSAC

FERRULE AND WIRING DETAILS


132KV BUSBAR PROT.N.MAIN-1 BU PANEL +BBP1-5
S/S 8709 - 132/13.8KV IN AL-KHARJ CITY
RIYADH SAUDI ARABIA


الشركة الوطنية لنقل الكهرباء




INDEX	PLANT NO.	DRAWING NUMBER	SHEET NO.	REV. NO.
-	C421	CD-322999	014	015

1	2	3	4	5		6	7	8	9	10
---	---	---	---	---	---	---	---	---	---	----

MANUFACTURER	SCHEMATICS DWG.NO	PANEL DESCRIPTION	PANEL REFERENCE
 <p>PROTECTION & SUBSTATION AUTOMATION</p>		SS 8709 13.8KV RELAY PANELS	
	CD-322952	13.8KV Capacitor Bank-1 Protection Panel	+CBP-1
	CD-322954	13.8KV Capacitor Bank-2 Protection Panel	+CBP-2
	CD-322956	13.8KV Capacitor Bank-2 Protection Panel	+CBP-3
	CD-322956	13.8 KV ACCS PANEL	+ACCS
	CD-322962	13.8KV ACSE PANEL	+ACSE
	CD-322968	13.8KV Under Voltage Load Shedding Panel	+UVLS
	CD-322964	13.8KV Under Frequency Load Shedding Panel-1	+UFLS01
	CD-322966	13.8KV Under Frequency Load Shedding Panel-2	+UFLS02

AS-BUILT BY _____ DATE _____			CONTRACT NO. 1113113/00		JOB ORDER NO. S-13656		DRAWING REFERENCES				 نقل الكهرباء الشركة الوطنية لنقل الكهرباء National Grid sa																
			DRAWN BY RIZ CHECKED BY KVR		132KV BUSBAR PROTN.MAIN-1 BU PANEL +B8P1-5				<table border="1"> <thead> <tr> <th>INDEX</th> <th>PLANT NO.</th> <th>DRAWING NUMBER</th> <th colspan="2">SHEET NO.</th> <th>REV. NO.</th> </tr> </thead> <tbody> <tr> <td>-</td> <td>C421</td> <td>CD-322999</td> <td>016</td> <td>051</td> <td>01</td> </tr> </tbody> </table>							INDEX	PLANT NO.	DRAWING NUMBER	SHEET NO.		REV. NO.	-	C421	CD-322999	016	051	01
INDEX	PLANT NO.	DRAWING NUMBER	SHEET NO.		REV. NO.																						
-	C421	CD-322999	016	051	01																						
<table border="1"> <tr> <td>01</td> <td>13 49</td> <td>FACTORY ASBUILT</td> </tr> <tr> <td>00</td> <td>13 05</td> <td>FOR APPROVAL</td> </tr> <tr> <td>REV. NO.</td> <td>DATE</td> <td>DESCRIPTION</td> </tr> </table>			01	13 49	FACTORY ASBUILT	00	13 05	FOR APPROVAL	REV. NO.	DATE	DESCRIPTION	DATE STARTED 28.01.2013 DATE COMPLETED _____		S/S 8709 - 132/13.8KV IN AL-KHARJ CITY													
01	13 49	FACTORY ASBUILT																									
00	13 05	FOR APPROVAL																									
REV. NO.	DATE	DESCRIPTION																									
			DPRG. DEPT. CTPD ENG. DEPT. AUT-PSAC		RIYADH SAUDI ARABIA																						

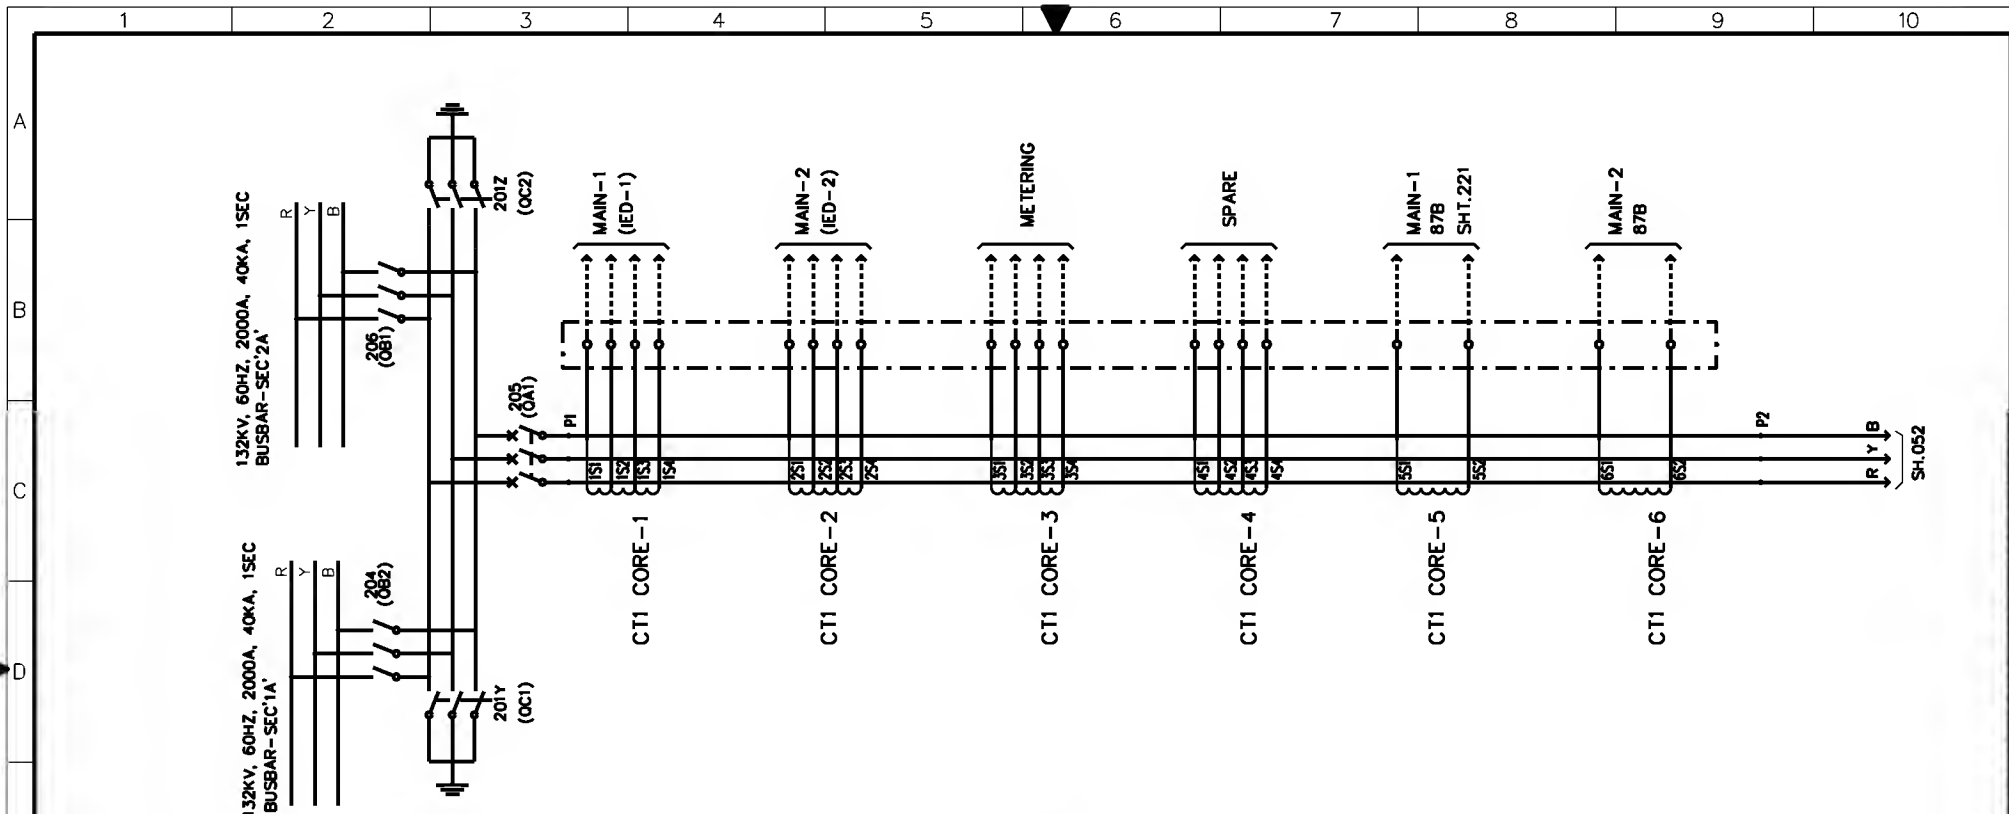


CT	RATIO	CLASS	VK IN VOLTS	IMAG @ VK IN mA	RCT IN (OHMS)	BURDEN IN VA	FUNCTION
CT1-1	1600-1200-800/1A	X	>1400	≤100	≤2	-	MAIN-1(IED-1)
CT1-2	1600-1200-800/1A	X	>1400	≤100	≤2	-	MAIN-2(IED-2)
CT1-3	1600-1200-800/1A	X	>1400	≤100	≤2	-	METERING
CT1-4	1600-1200-800/1A	X	>1400	≤100	≤2	-	SPARE
CT1-5	2000/1A	X	>600	≤25	≤5	-	87B MAIN-1
CT1-6	2000/1A	X	>600	≤25	≤5	-	87B MAIN-2

AS-BUILT BY _____ DATE _____ CONTRACT NO. **11131113/00** JOB ORDER NO. **S-13656**

01	13 49	FACTORY ASBUILT	DRAWN BY RIZ CHECKED BY KVR
00	13 05	FOR APPROVAL	DATE STARTED 28.01.2013 DATE COMPLETED _____
REV. NO.	DATE	DESCRIPTION	OPRG. DEPT. CTPD ENG. DEPT. AUT-PSAC

PRIMARY SYSTEM (UCF 8020 BAY-002)
132KV BUSBAR PROTN.MAIN-1 BU PANEL +BBP1-5
S/S 8709 - 132/13.8KV IN AL-KHARJ CITY
RIYADH SAUDI ARABIA

الشركة الوطنية لنقل الكهرباء		نقل الكهرباء	
National Grid sa		National Grid sa	
INDEX	PLANT NO.	DRAWING NUMBER	SHEET NO.
-	C421	CD-322999	051 052
			REV. NO.
			01

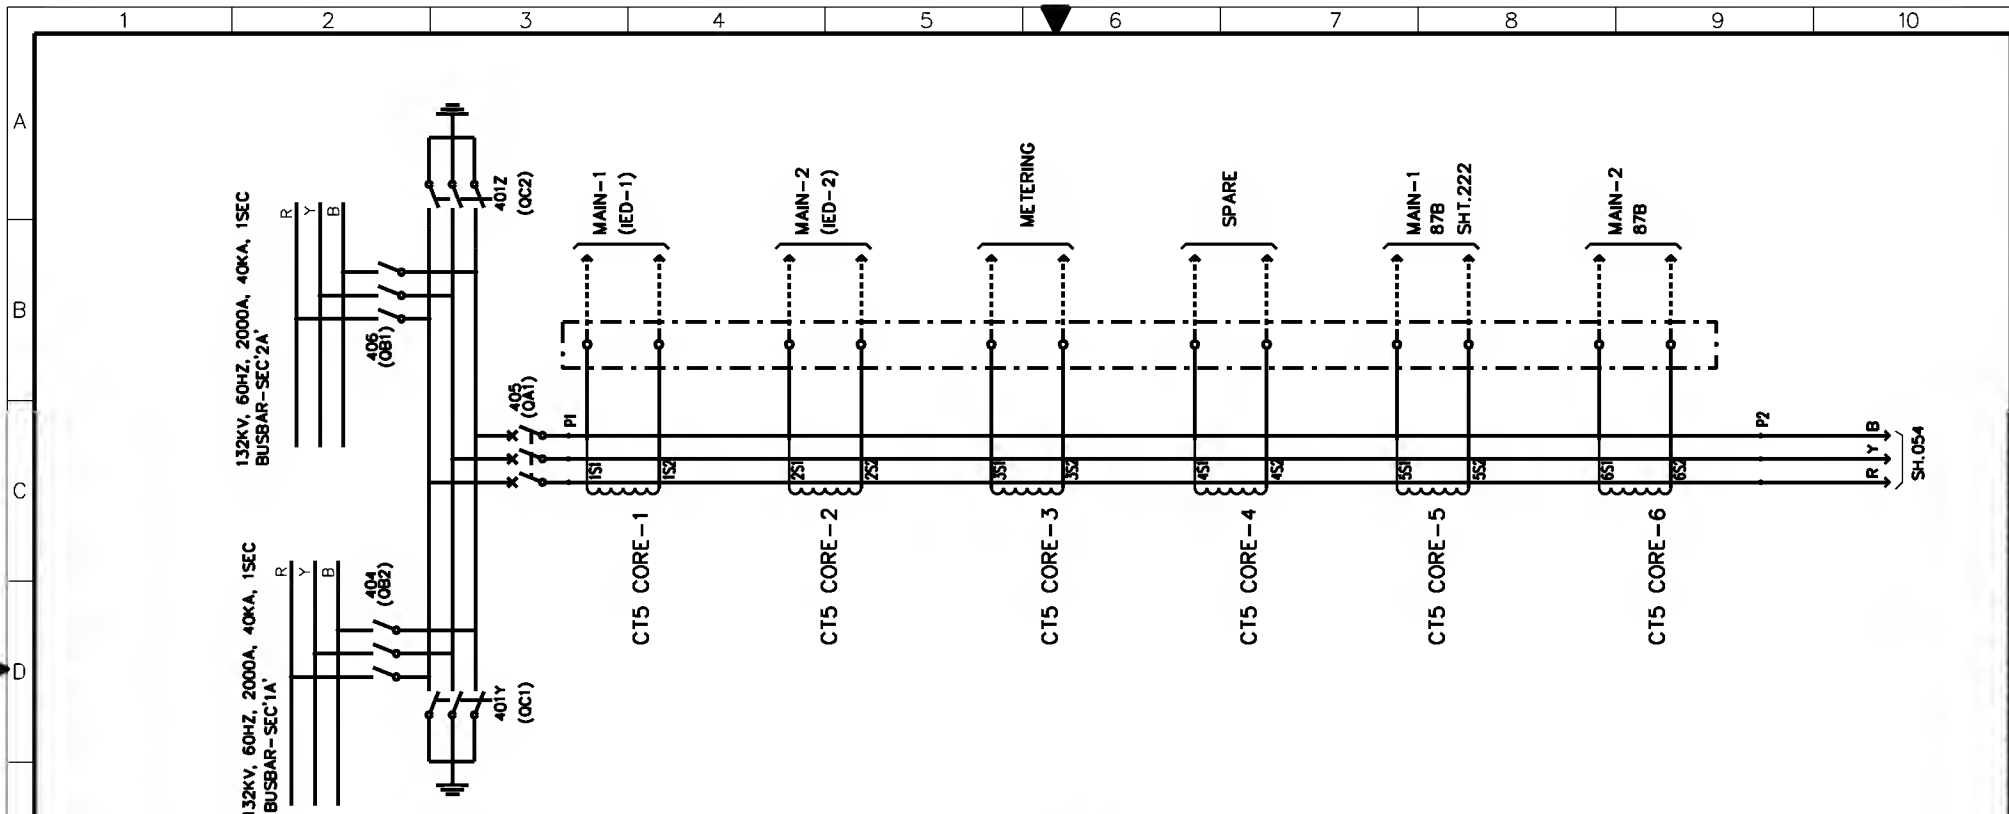

CT	RATIO	CLASS	VK IN VOLTS	IMAG @ VK IN mA	RCT IN (OHMS)	BURDEN IN VA	FUNCTION
CT5-1	300/1A	X	>360	≤50	≤1	-	MAIN-1(IED-1) TRAF0 PROT.N.
CT5-2	300/1A	X	>360	≤50	≤1	-	MAIN-2(IED-2) TRAF0 PROT.N.
CT5-3	300/1A	0.2Fs5	-	-	-	30	METERING
CT5-4	300/1A	5P20	-	-	-	30	SPARE
CT5-5	2000/1A	X	>600	≤25	≤5	-	87B MAIN-1
CT5-6	2000/1A	X	>600	≤25	≤5	-	87B MAIN-2

AS-BUILT BY _____ DATE _____ CONTRACT NO. **11131113/00** JOB ORDER NO. **S-13656**

01	13 49	FACTORY ASBUILT	DRAWN BY RIZ CHECKED BY KVR
00	13 05	FOR APPROVAL	DATE STARTED 28.01.2013 DATE COMPLETED _____
REV. NO.	DATE	DESCRIPTION	OPRG. DEPT. CTPD ENG. DEPT. AUT-PSAC


PRIMARY SYSTEM (TRANSFORMER- GT3 BAY-004)

132KV BUSBAR PROT.N.MAIN-1 BU PANEL +BBPI-5
S/S 8709 - 132/13.8KV IN AL-KHARJ CITY
RIYADH SAUDI ARABIA




الشركة الوطنية لنقل الكهرباء




INDEX	PLANT NO.	DRAWING NUMBER	SHEET NO.	REV. NO.
-	C421	CD-322999	053 054	01

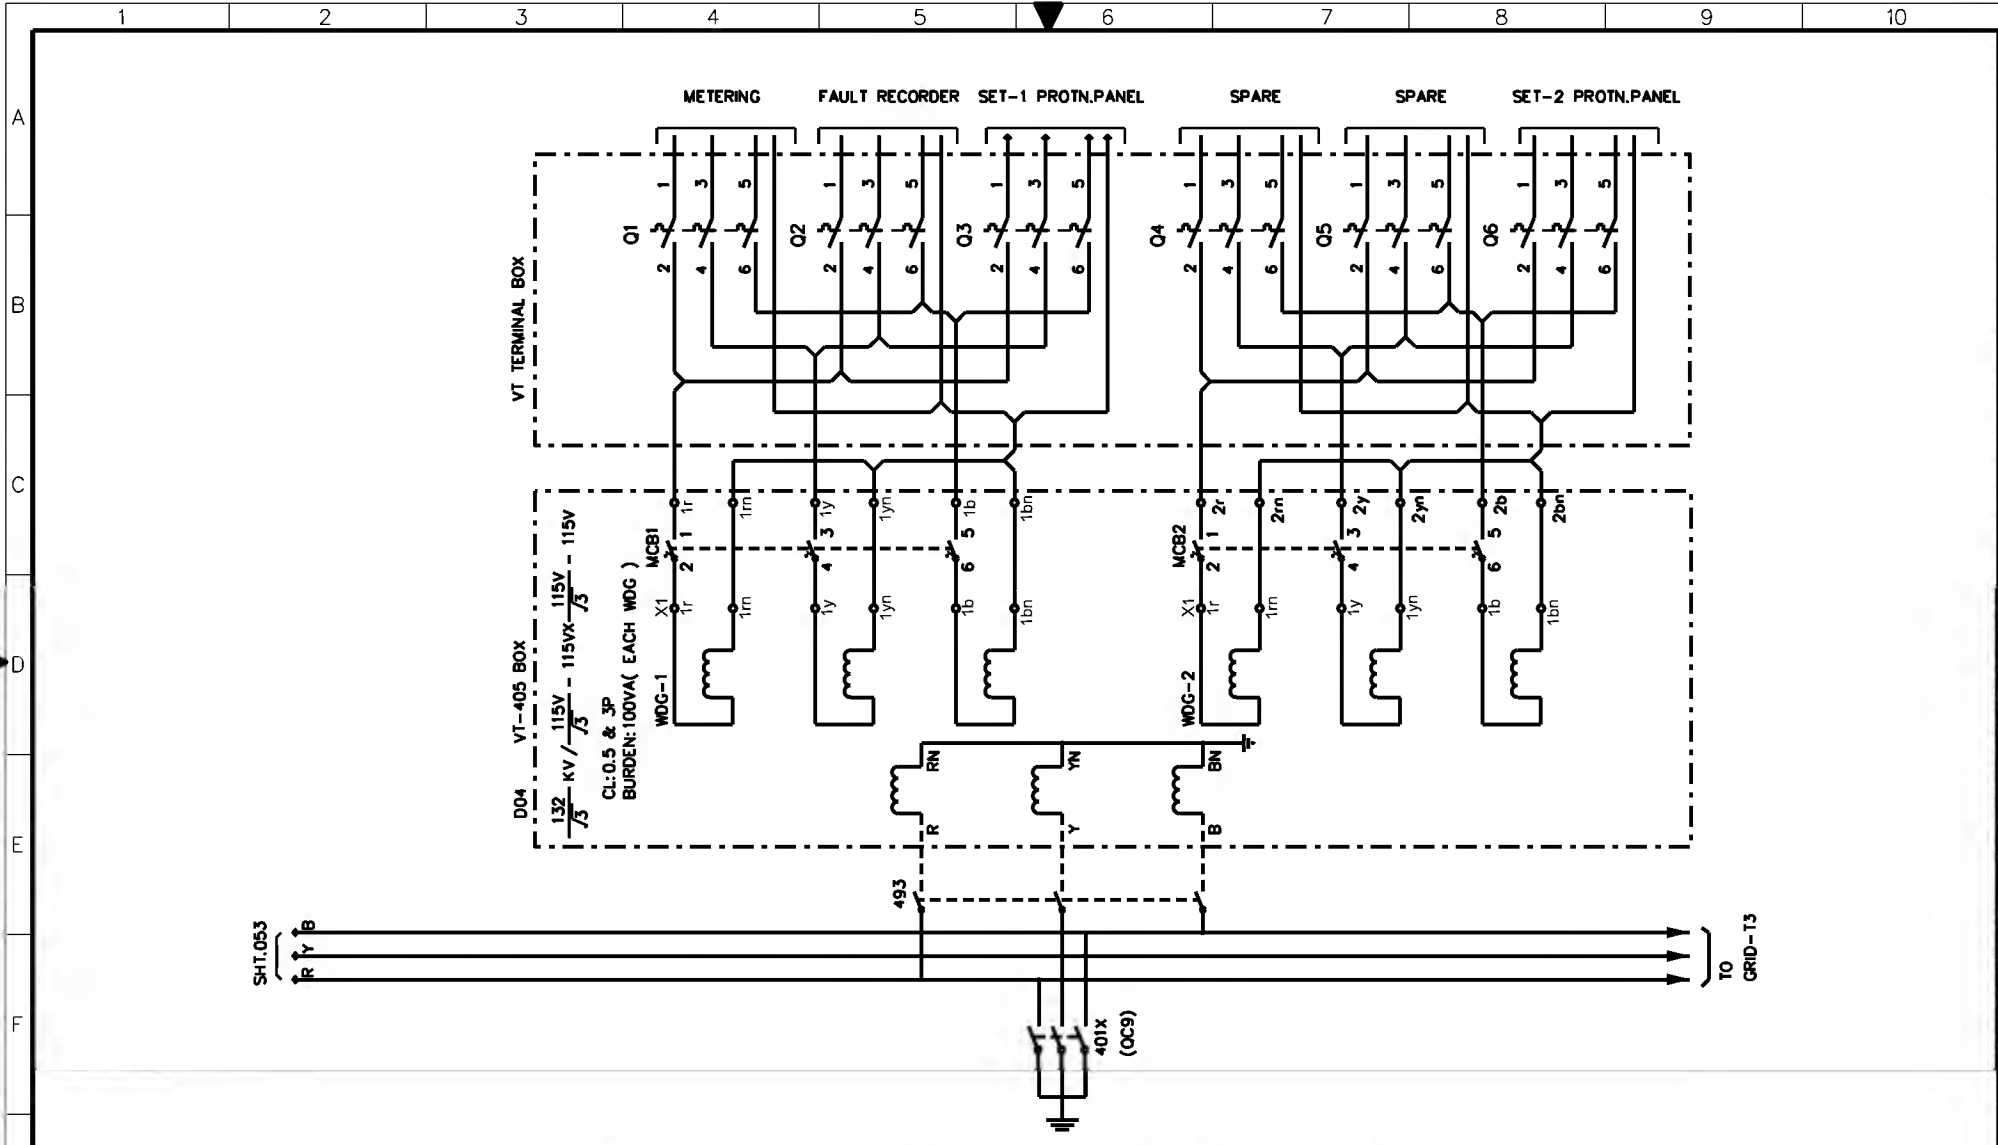

AS-BUILT BY _____ DATE _____			CONTRACT NO. 11131113/00		JOB ORDER NO. S-13656		PRIMARY SYSTEM (TRANSFORMER- GT3 BAY-D04)				الشركة الوطنية لنقل الكهرباء			
DRAWN BY RIZ CHECKED BY KVR			DATE STARTED 28.01.2013		DATE COMPLETED _____		132KV BUSBAR PROTN.MAIN-1 BU PANEL +BBP1-5				National Grid sa			
01 13 49 FACTORY ASBUILT			OPRG. DEPT. CTPD		ENG. DEPT. AUT-PSAC		S/S 8709 - 132/13.8KV IN AL-KHARJ CITY				National Grid sa			
00 13 05 FOR APPROVAL			INDEX		PLANT NO.		DRAWING NUMBER		SHEET NO.		REV. NO.			
REV. NO.			-		C421		CD-322999		054 055		01			


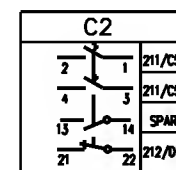
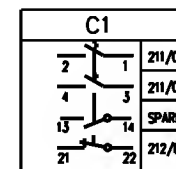
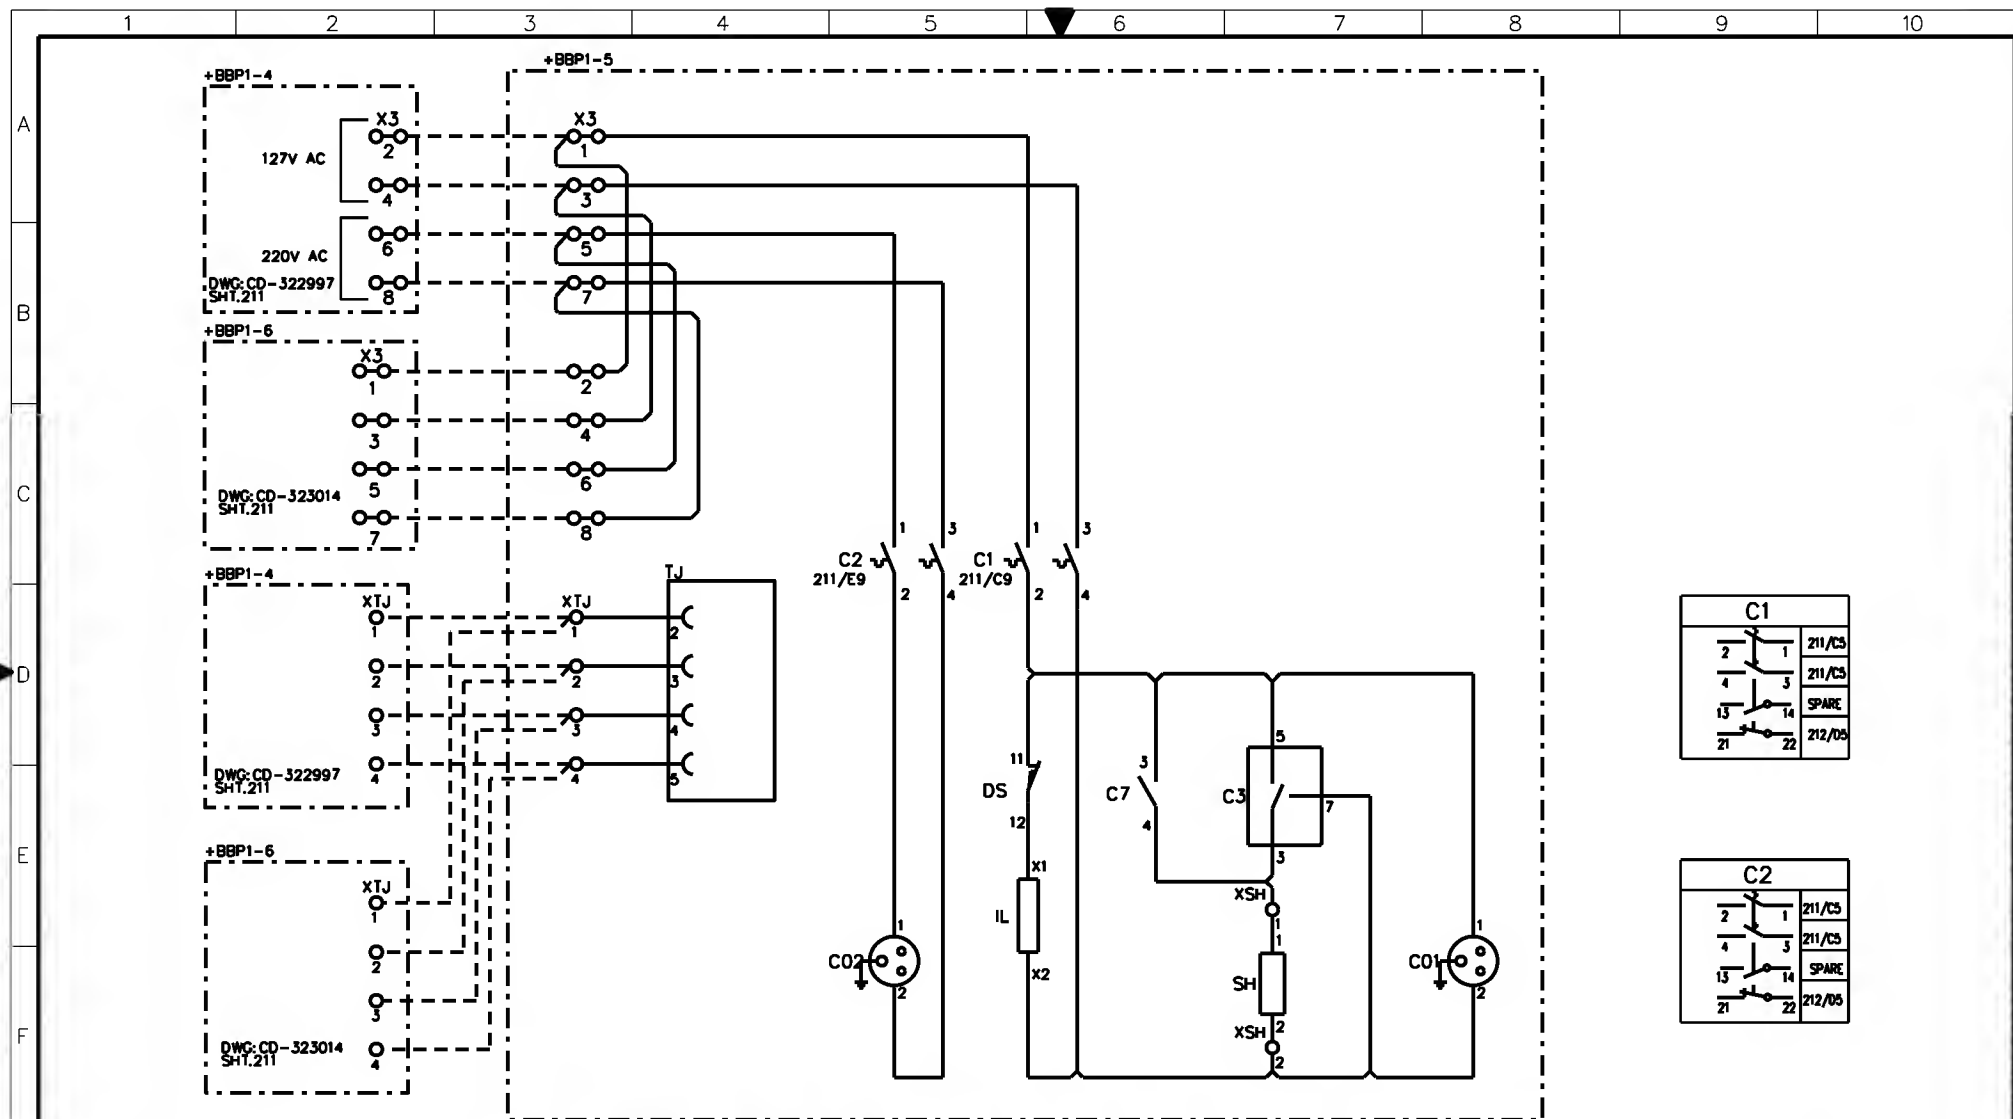


AS-BUILT BY		DATE	CONTRACT NO.	11131113/00	JOB ORDER NO.	S-13656	AC SUPPLY FOR ILLUMINATION & POWER SOCKET				الشركة الوطنية لنقل الكهرباء			
01		13 49	FACTORY ASBUILT		DRAWN BY	RIZ	CHECKED BY	KVR	132KV BUSBAR PROTN.MAIN-1 BU PANEL +BBP1-5		National Grid sa		نقل الكهرباء	
00		13 05	FOR APPROVAL		DATE STARTED	28.01.2013	DATE COMPLETED		S/S 8709 - 132/13.8KV IN AL-KHARJ CITY		INDEX	PLANT NO.	DRAWING NUMBER	SHEET NO.
REV. NO.	DATE		DESCRIPTION		OPRG. DEPT.	CTPD	ENG. DEPT.	AUT-PSAC	RIYADH		-	C421	CD-322999	211
									SAUDI ARABIA					212
														01

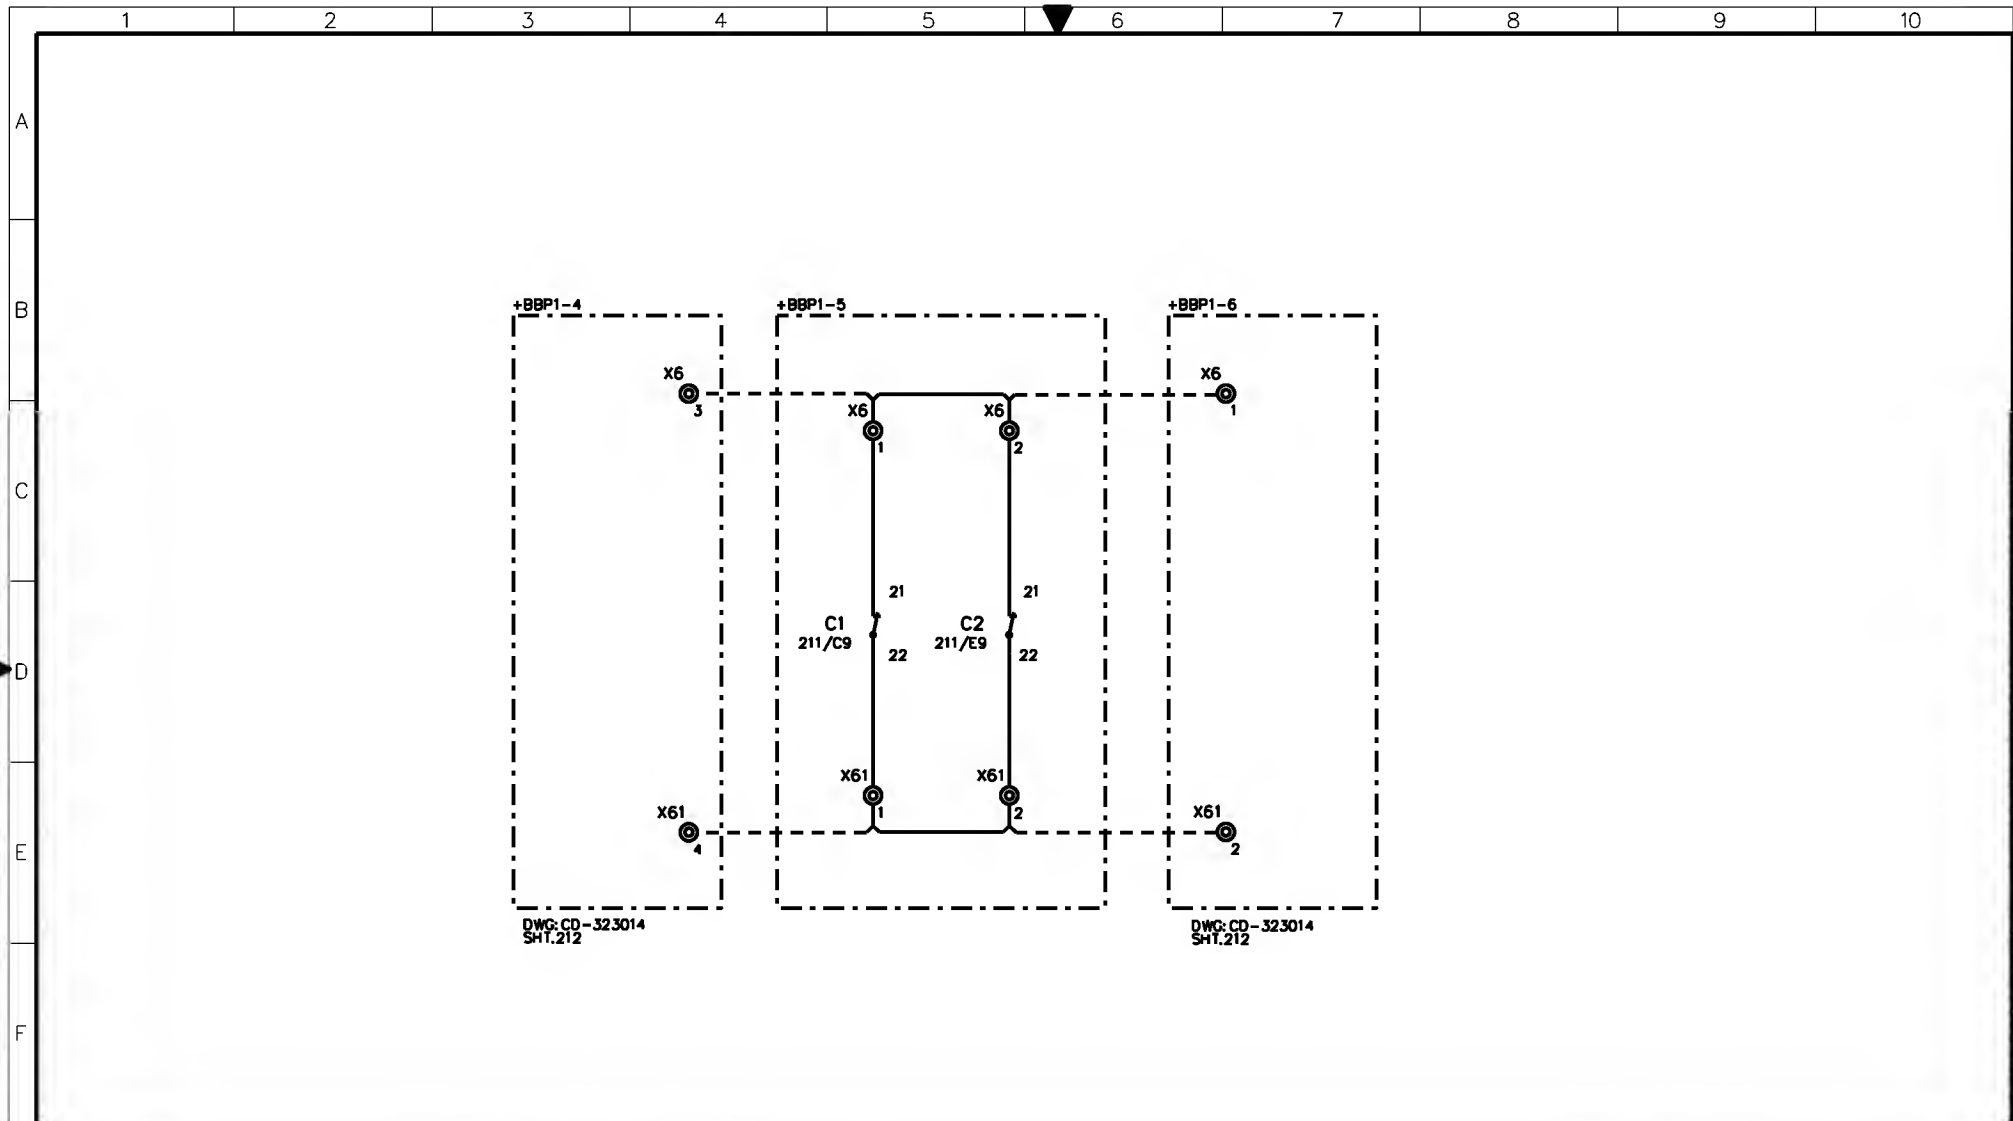


AS-BUILT BY _____ DATE _____			CONTRACT NO. 11131113/00		JOB ORDER NO. S-13656		CUB.LIGHTING,HEATER&SOKET ALARM CKT.				نقل الكهرباء National Grid sa									
01	13 49	FACTORY ASBUILT	DRAWN BY RIZ CHECKED BY KVR				132KV BUSBAR PROTN.MAIN-1 BU PANEL +BBP1-5													
00	13 05	FOR APPROVAL	DATE STARTED 28.01.2013 DATE COMPLETED _____				S/S 8709 - 132/13.8KV IN AL-KHARJ CITY				INDEX	PLANT NO.								
REV. NO.	DATE	DESCRIPTION	OPRG. DEPT. CTPD ENG. DEPT. AUT-PSAC				RIYADH SAUDI ARABIA				-	C421								
											DRAWING NUMBER CD-322999									
											SHEET NO.	REV. NO.								
											212	01								


THIS DRAWING AND THE INFORMATION CONTAINED HEREIN ARE THE SOLE PROPERTY OF NATIONAL GRID SA. NO REPRODUCTION OR TRANSMISSION IN ANY FORM OR BY ANY MEANS, WITHOUT THE WRITTEN CONSENT OF ITS OWNER.

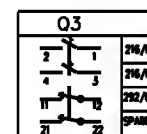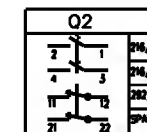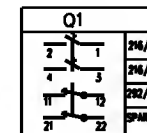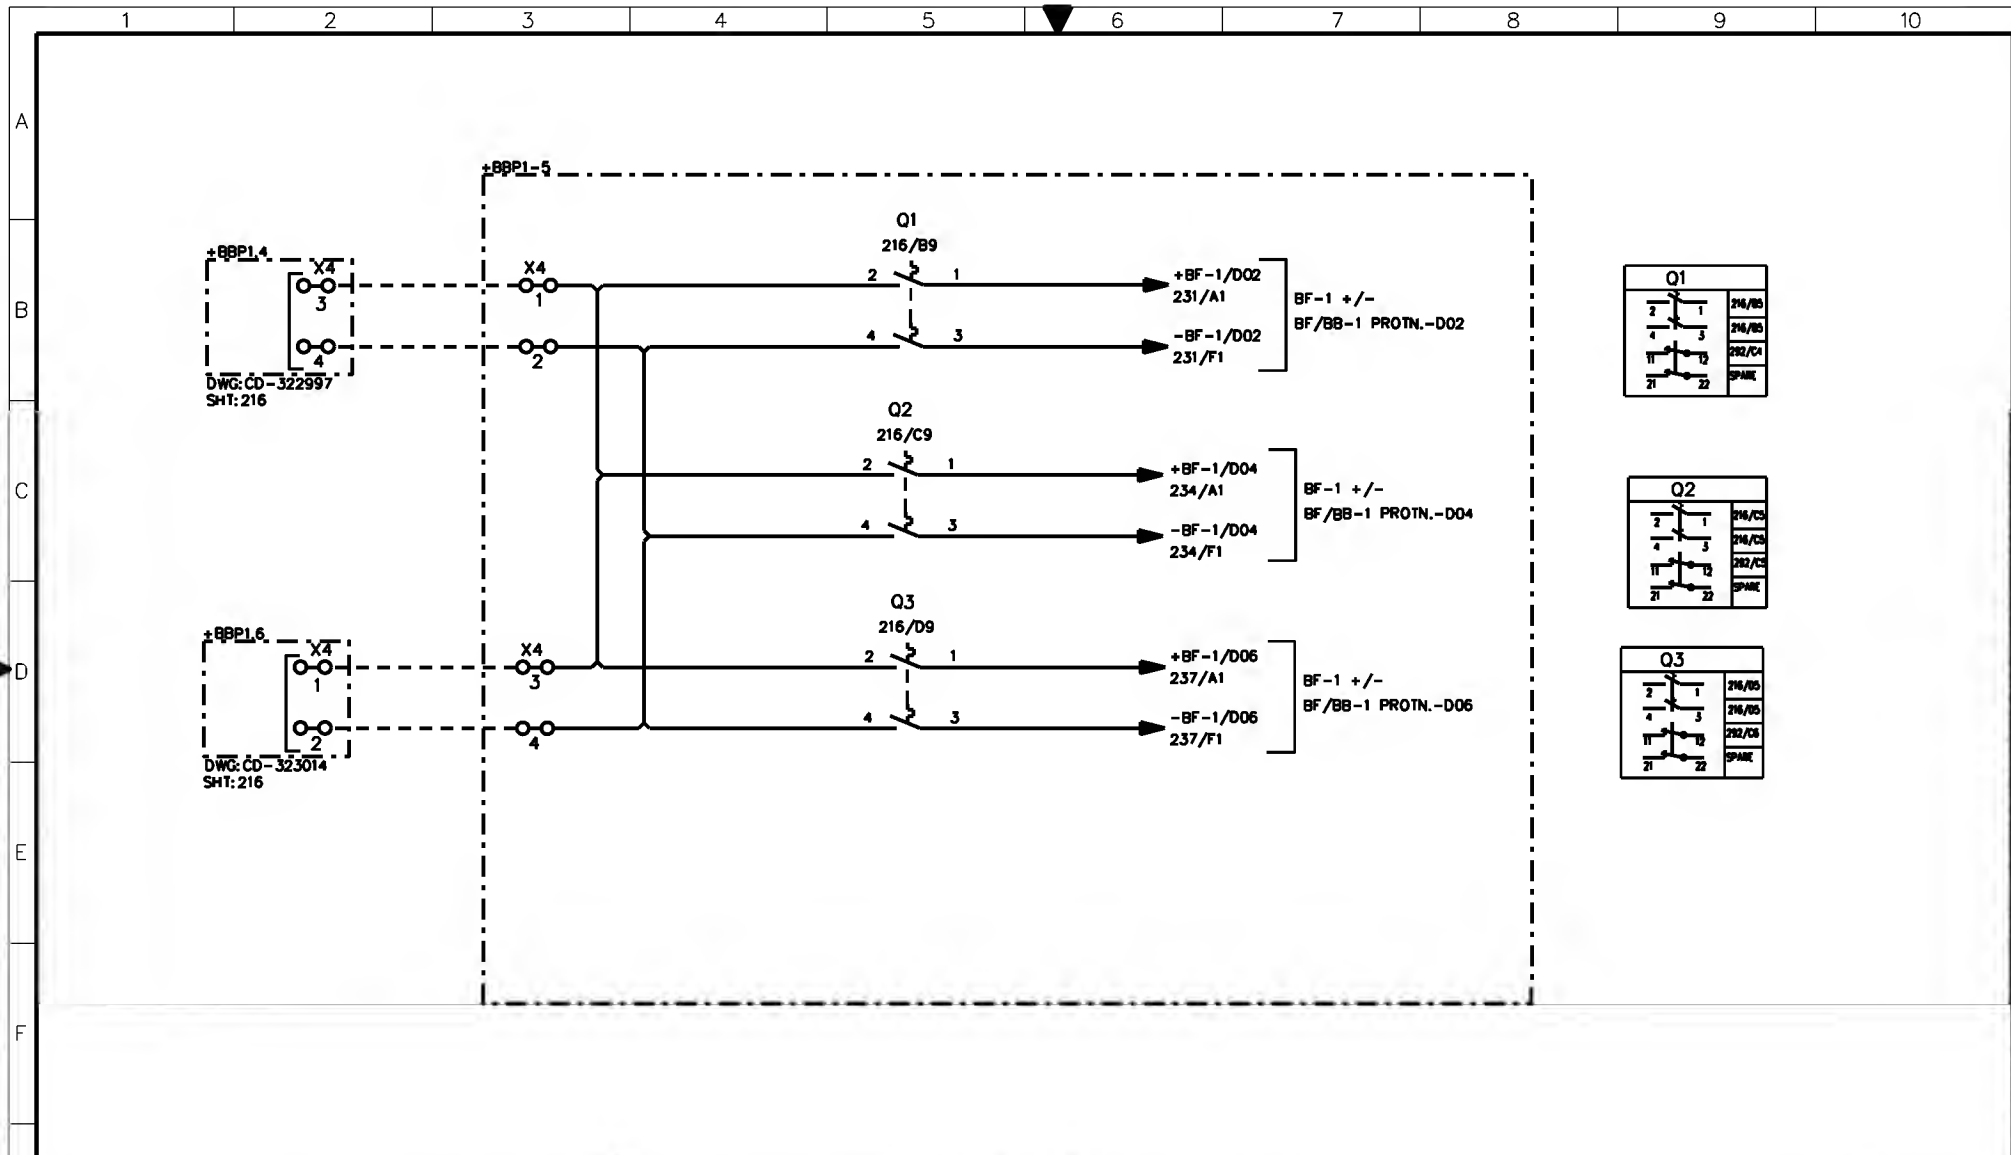


AS-BUILT BY _____ DATE _____			CONTRACT NO. 1113113/00		JOB ORDER NO. S-13656		DC SUPPLY DISTRIBUTION			الشركة الوطنية لنقل الكهرباء		
DRAWN BY RIZ CHECKED BY KVR			DATE STARTED 28.01.2013 DATE COMPLETED _____			132KV BUSBAR PROTN.MAIN-1 BU PANEL +BBP1-5			National Grid sa			
DATE STARTED 28.01.2013 DATE COMPLETED _____			DATE STARTED _____ DATE COMPLETED _____			S/S 8709 - 132/13.8KV IN AL-KHARJ CITY			INDEX PLANT NO. DRAWING NUMBER SHEET NO. REV. NO.			
PRG. DEPT. CTPD ENG. DEPT. AUT-PSAC			RIYADH SAUDI ARABIA			- C421 CD-322999 216 221 01						

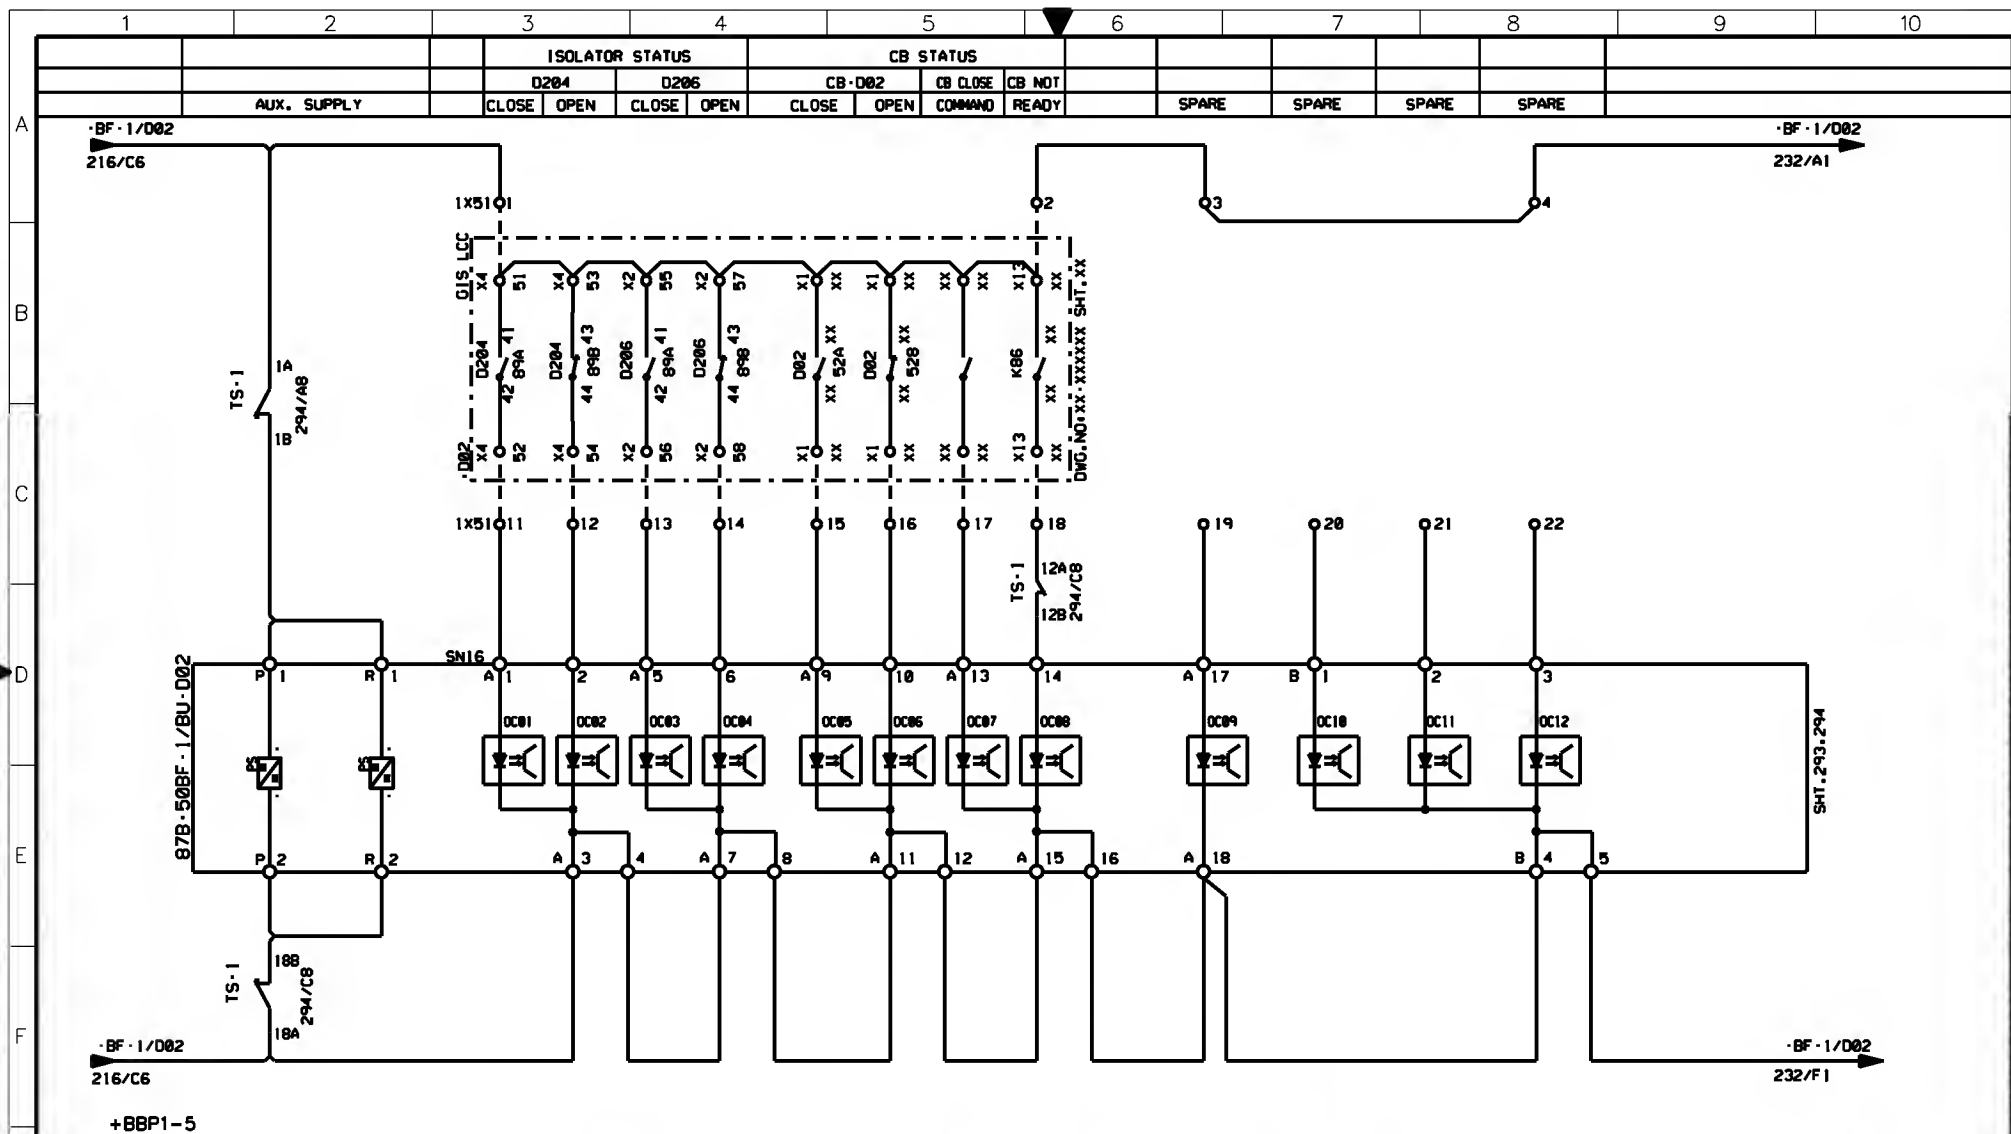

AS-BUILT BY _____ DATE _____		CONTRACT NO. 1113113/00	JOB ORDER NO. S-13656	87B-50BF-1/BU-D02 PROTECTION RELAY - BINARY INPUTS		الشركة الوطنية لنقل الكهرباء		نقل الكهرباء	
01	13 49	FACTORY ASBUILT		DRAWN BY RIZ	CHECKED BY KVR	132KV BUSBAR PROTN.MAIN-1 BU PANEL +BBP1-5		National Grid sa	
00	13 05	FOR APPROVAL		DATE STARTED 28.01.2013	DATE COMPLETED _____	S/S 8709 - 132/13.8KV IN AL-KHARJ CITY		INDEX PLANT NO. DRAWING NUMBER SHEET NO. REV. NO.	
REV. NO.	DATE	DESCRIPTION		OPRG. DEPT. CTPO	ENG. DEPT. AUT-PSAC	RIYADH SAUDI ARABIA		- C421 CD-322999 231 232 01	

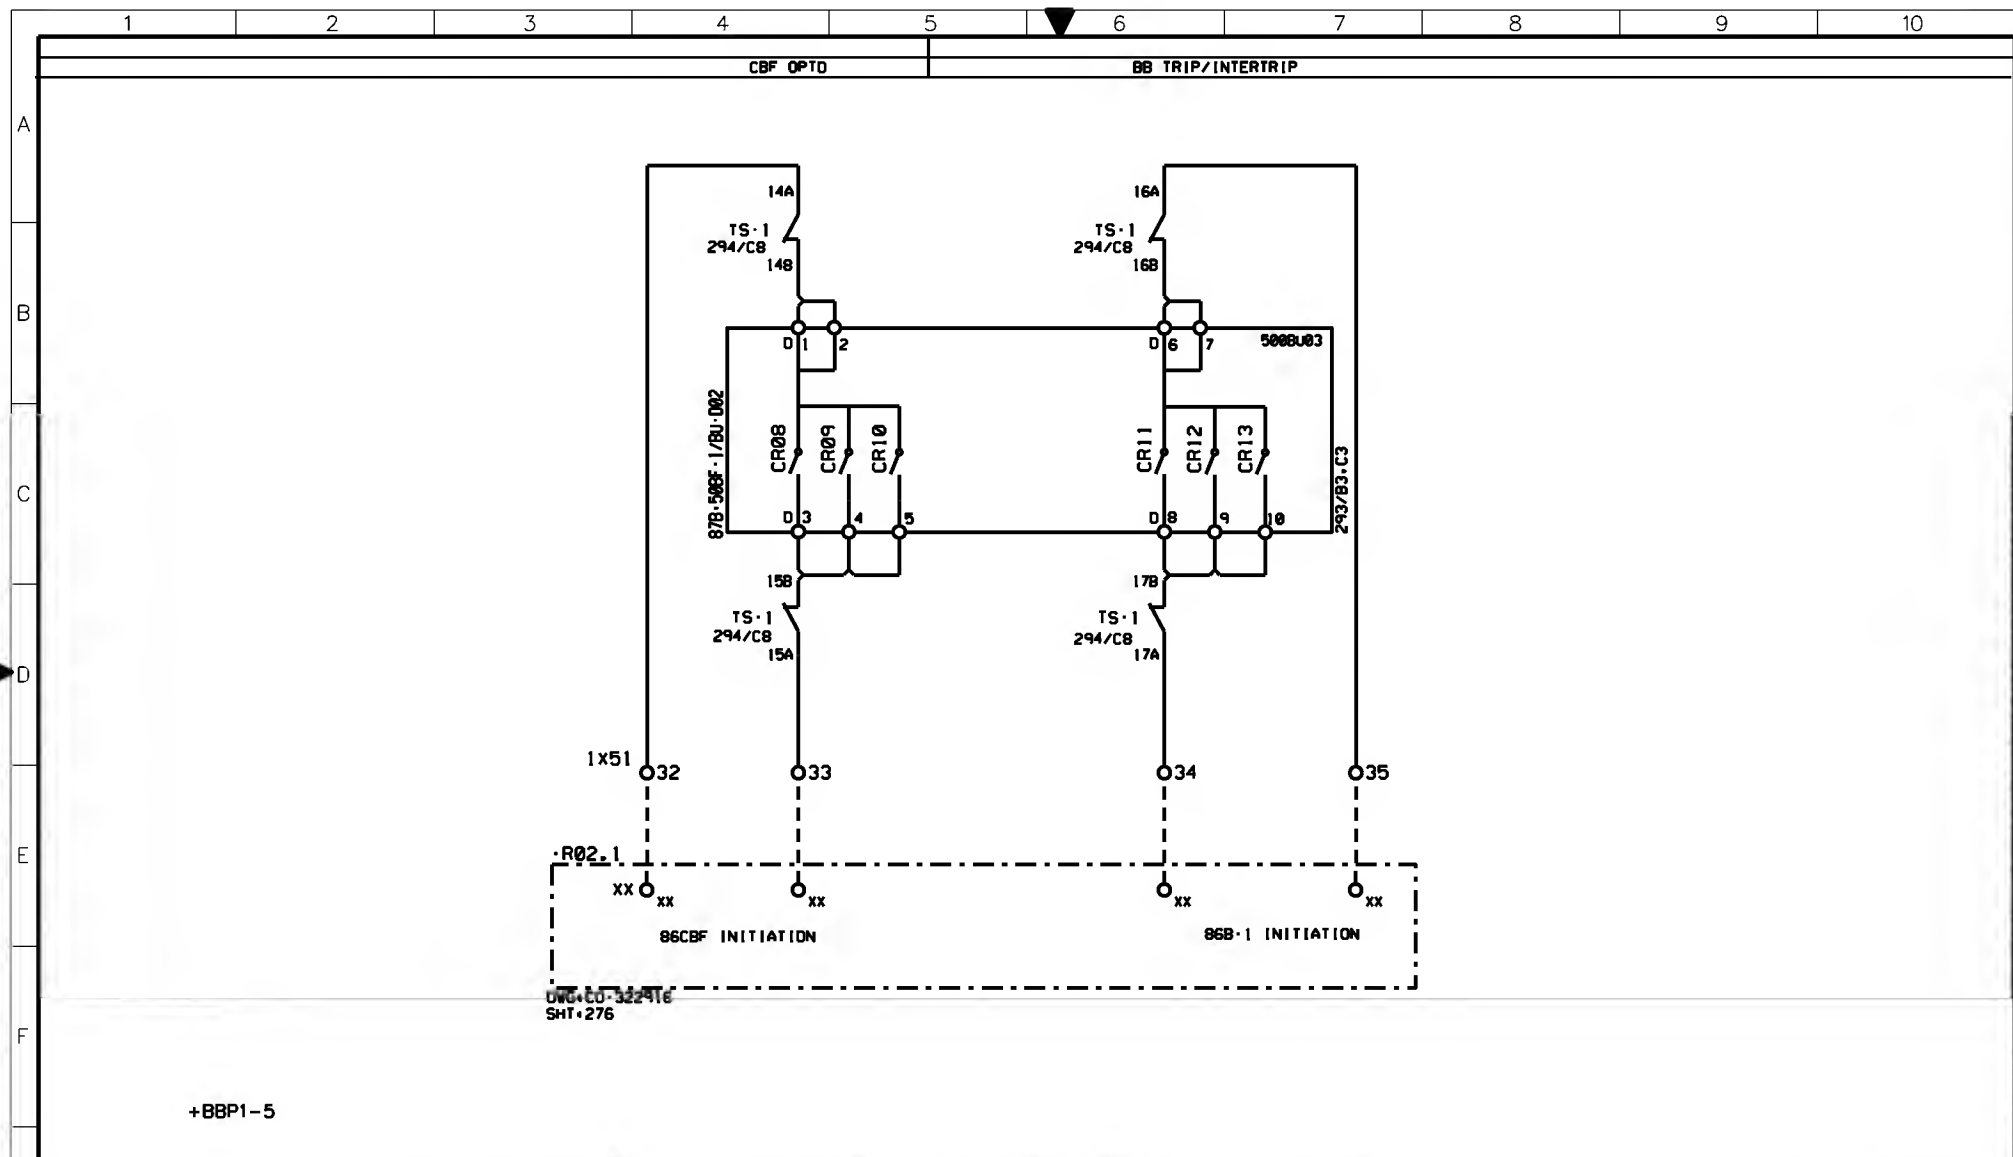


AS-BUILT BY _____ DATE _____			CONTRACT NO. 1113113/00		JOB ORDER NO. S-13656		CBF & BUSBAR PROTN-1 TRIP RELAY CIRCUIT				<div style="display: flex; justify-content: space-between; align-items: center;"> <div>الشركة الوطنية لنقل الكهرباء</div> <div> National Grid sa </div> </div>				
01	13 49	FACTORY ASBUILT	DRAWN BY RIZ CHECKED BY KVR		DATE STARTED 28.01.2013 DATE COMPLETED _____		132KV BUSBAR PROTN.MAIN-1 BU PANEL +BBP1-5								
00	13 05	FOR APPROVAL	OPRG. DEPT. CTPD ENG. DEPT. AUT-PSAC		S/S 8709 - 132/13.8KV IN AL-KHARJ CITY		RIYADH SAUDI ARABIA				INDEX	PLANT NO.	DRAWING NUMBER	SHEET NO.	REV. NO.
REV. NO.	DATE	DESCRIPTION									-	C421	CD-322999	233	01

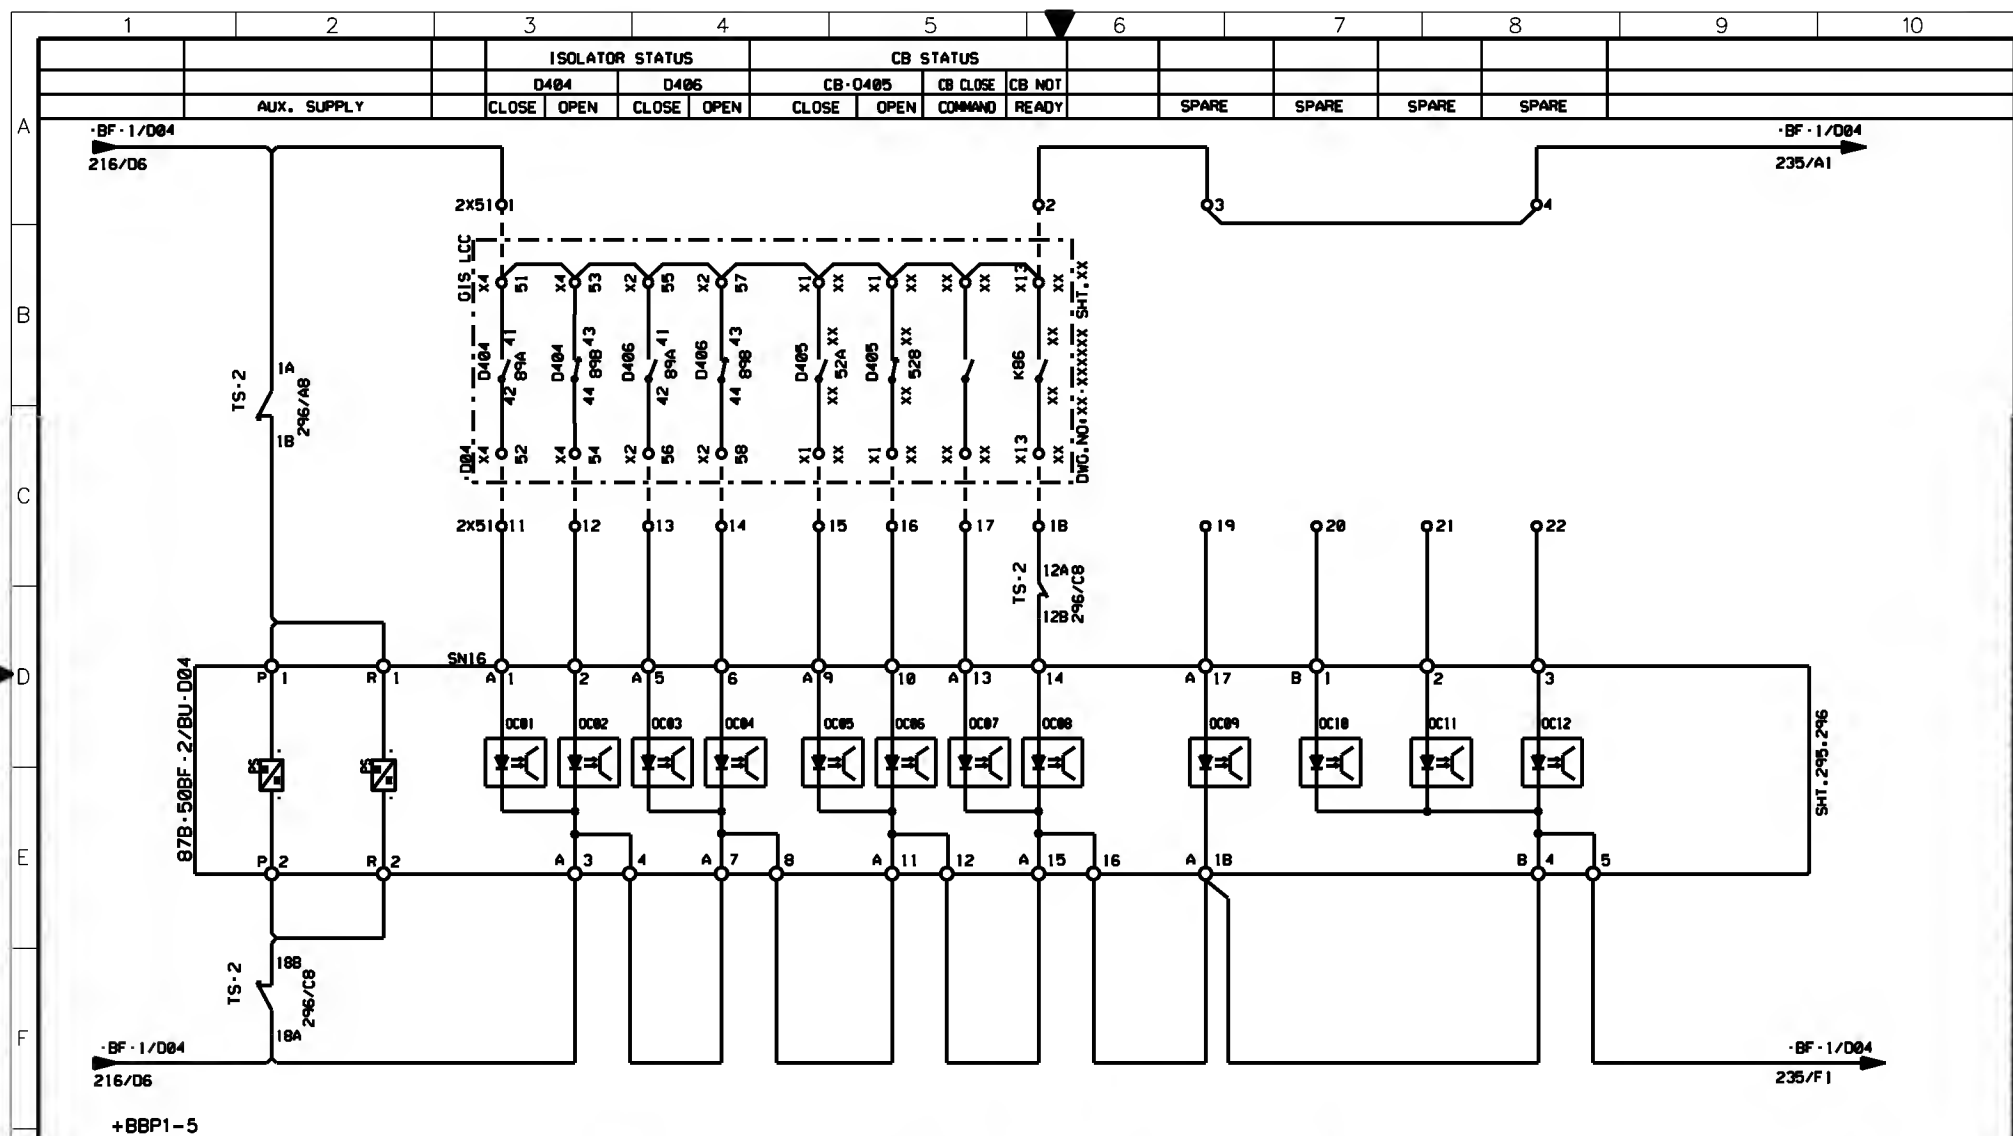


AS-BUILT BY _____ DATE _____		CONTRACT NO. 1113113/00	JOB ORDER NO. S-13656	87B-50BF-1/BU-D04 PROTECTION RELAY - BINARY INPUTS	
01	13 49	FACTORY ASBUILT		132KV BUSBAR PROTN.MAIN-1 BU PANEL +BBP1-5	
00	13 05	FOR APPROVAL		S/S 8709 - 132/13.8KV IN AL-KHARJ CITY	
REV. NO.	DATE	DESCRIPTION		RIYADH SAUDI ARABIA	
		DRAWN BY RIZ	CHECKED BY KVR		
		DATE STARTED 28.01.2013	DATE COMPLETED _____		
		PRG. DEPT. CTPO	ENG. DEPT. AUT-PSAC		


الشركة الوطنية لنقل الكهرباء		نقل الكهرباء	
National Grid sa		National Grid sa	
INDEX	PLANT NO.	DRAWING NUMBER	SHEET NO.
-	C421	CD-322999	234 235
		REV. NO.	01

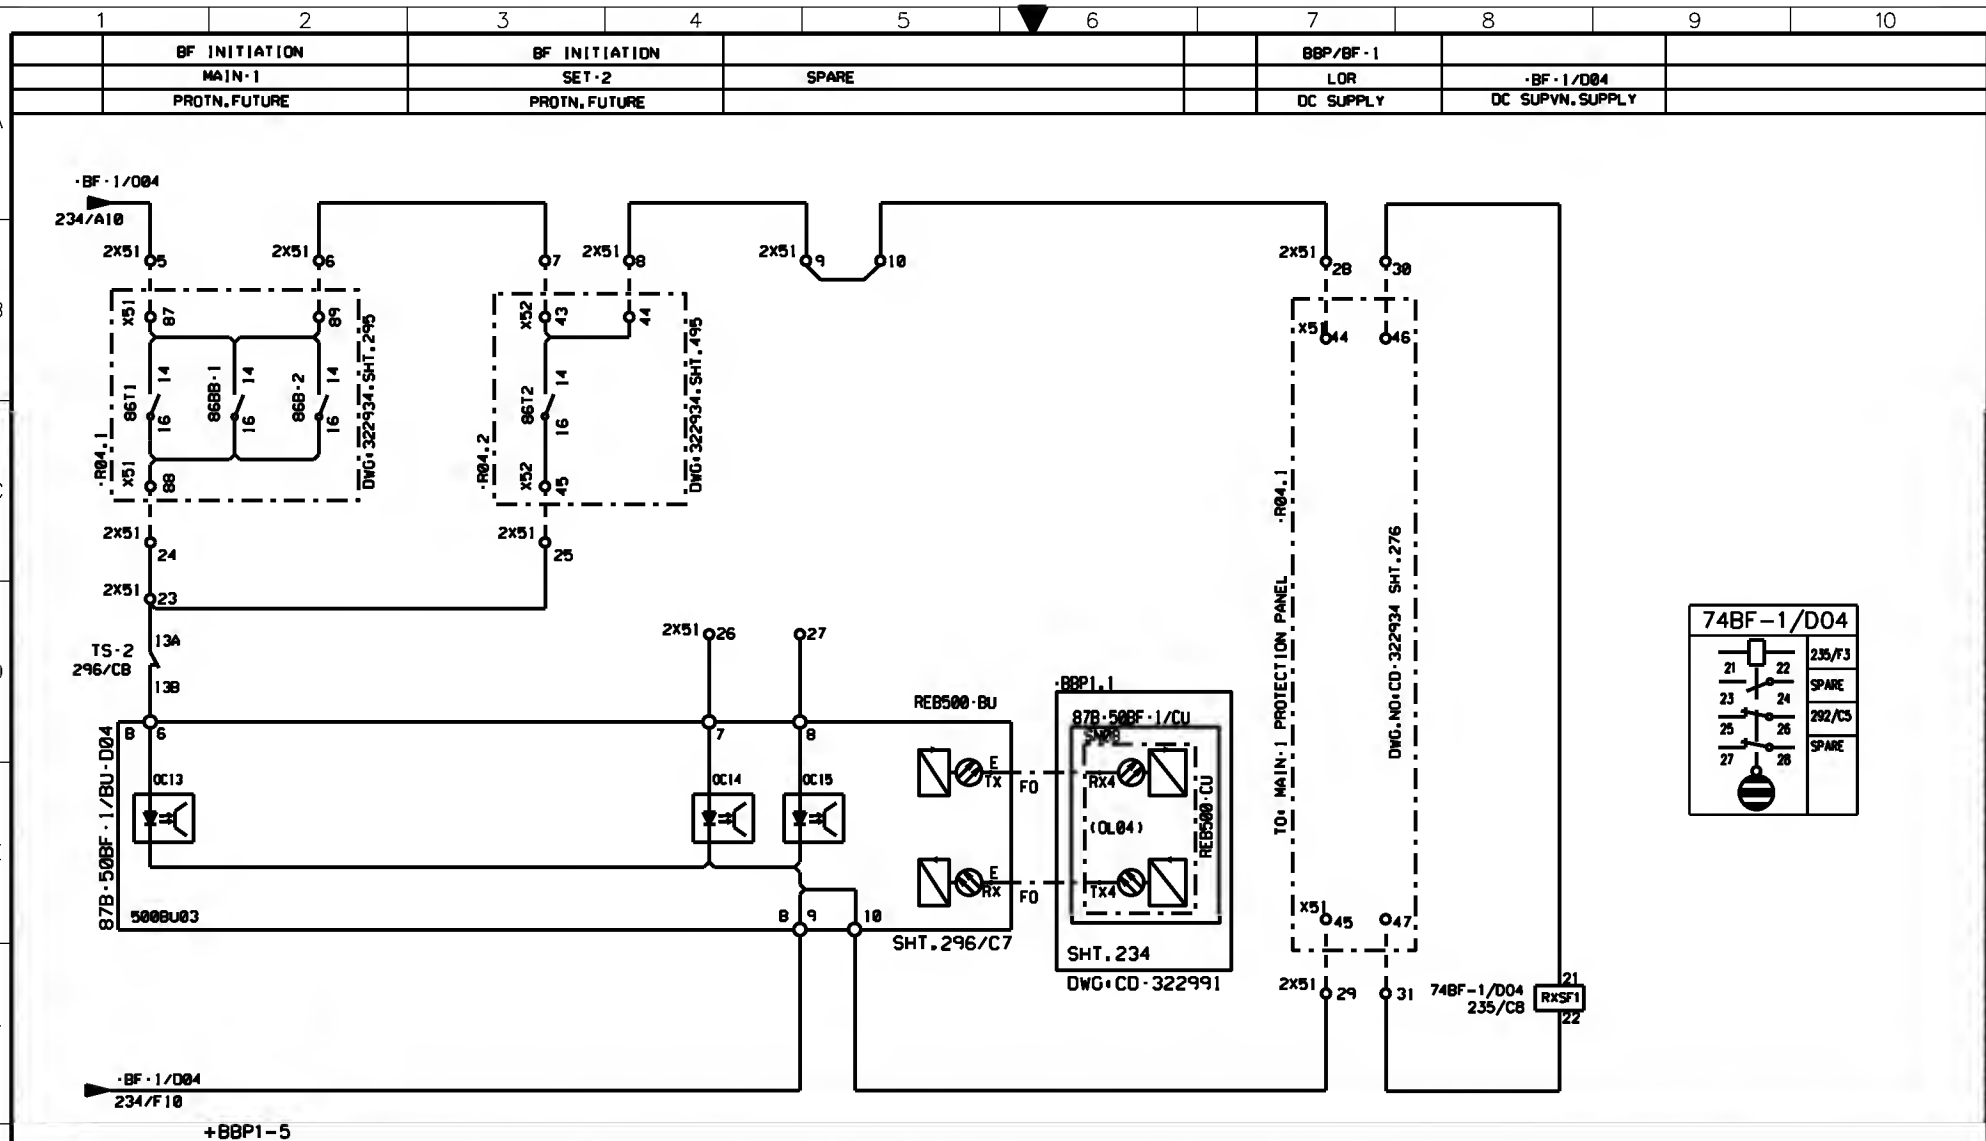

AS-BUILT BY _____ DATE _____		CONTRACT NO. 1113113/00	JOB ORDER NO. S-13656	87B-50BF-1/BU-D04 PROTECTION RELAY - BINARY INPUTS		الشركة الوطنية لنقل الكهرباء	
DRAWN BY RIZ CHECKED BY KVR		DATE STARTED 28.01.2013 DATE COMPLETED _____		132KV BUSBAR PROTN.MAIN-1 BU PANEL +BBP1-5		National Grid sa	
FOR APPROVAL		S/S 8709 - 132/13.8KV IN AL-KHARJ CITY		RIYADH		SAUDI ARABIA	
PRG. DEPT. CTPD ENG. DEPT. AUT-PSAC		INDEX PLANT NO. DRAWING NUMBER - C421 CD-322999		SHEET NO. 235 CONT. 236		REV. NO. 01	

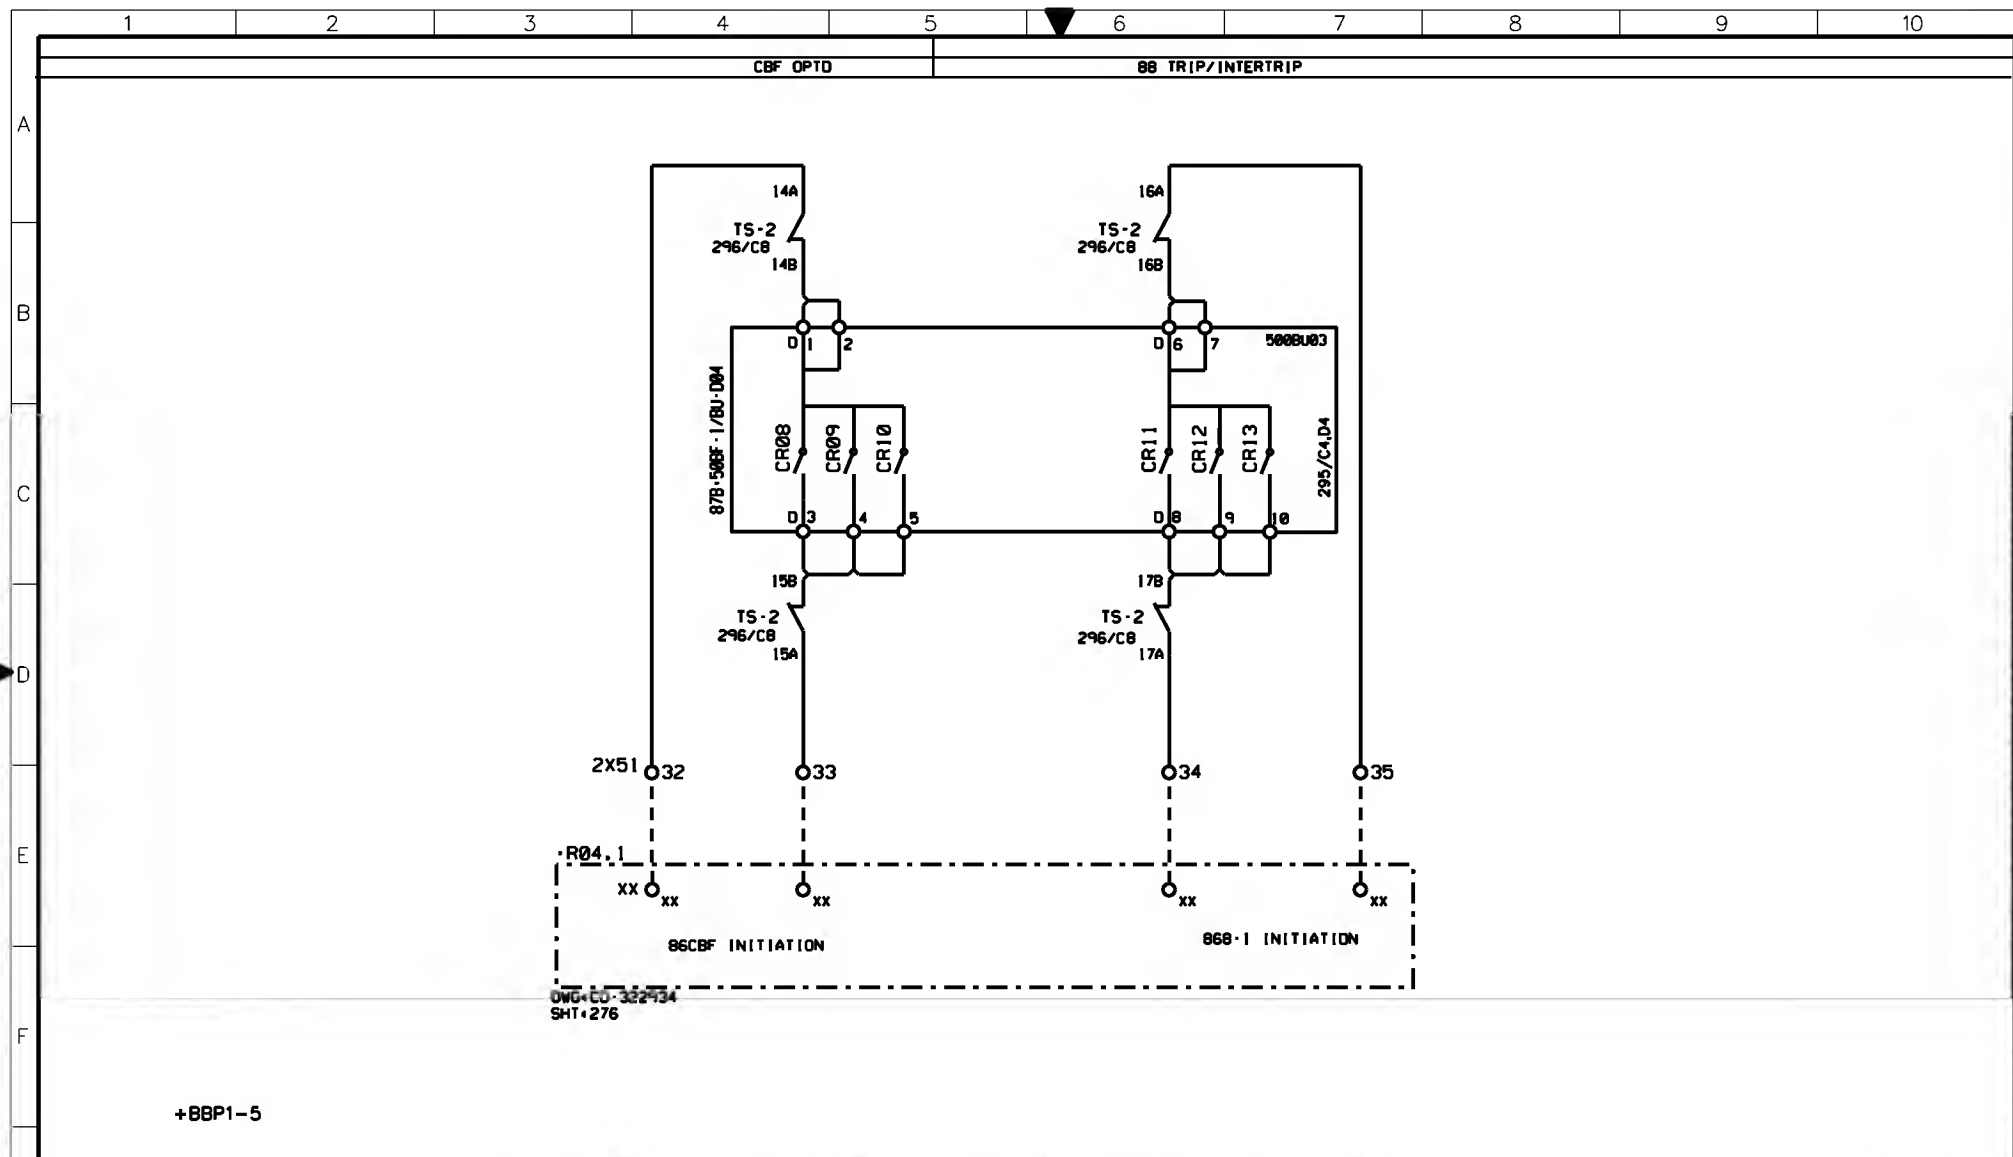

AS-BUILT BY _____ DATE _____			CONTRACT NO. 1113113/00		JOB ORDER NO. S-13656		CBF-1 & BUSBAR PROTN-1 TRIP RELAY CIRCUIT				<div style="display: flex; align-items: center;"> <div style="flex: 1;">الشركة الوطنية لنقل الكهرباء</div> <div style="flex: 1; text-align: center;"> </div> <div style="flex: 1; text-align: right;">نقل الكهرباء</div> </div> <div style="text-align: right; font-size: small;">National Grid sa</div>							
01	13 49	FACTORY ASBUILT	DRAWN BY RIZ CHECKED BY KVR		DATE STARTED 28.01.2013 DATE COMPLETED _____		132KV BUSBAR PROTN.MAIN-1 BU PANEL +BBP1-5											
00	13 05	FOR APPROVAL	OPRG. DEPT. CTPD ENG. DEPT. AUT-PSAC				S/S 8709 - 132/13.8KV IN AL-KHARJ CITY											
REV. NO.	DATE	DESCRIPTION					RIYADH SAUDI ARABIA				INDEX	PLANT NO.	DRAWING NUMBER	SHEET NO.	REV. NO.			
											-	C421	CD-322999	236	01			

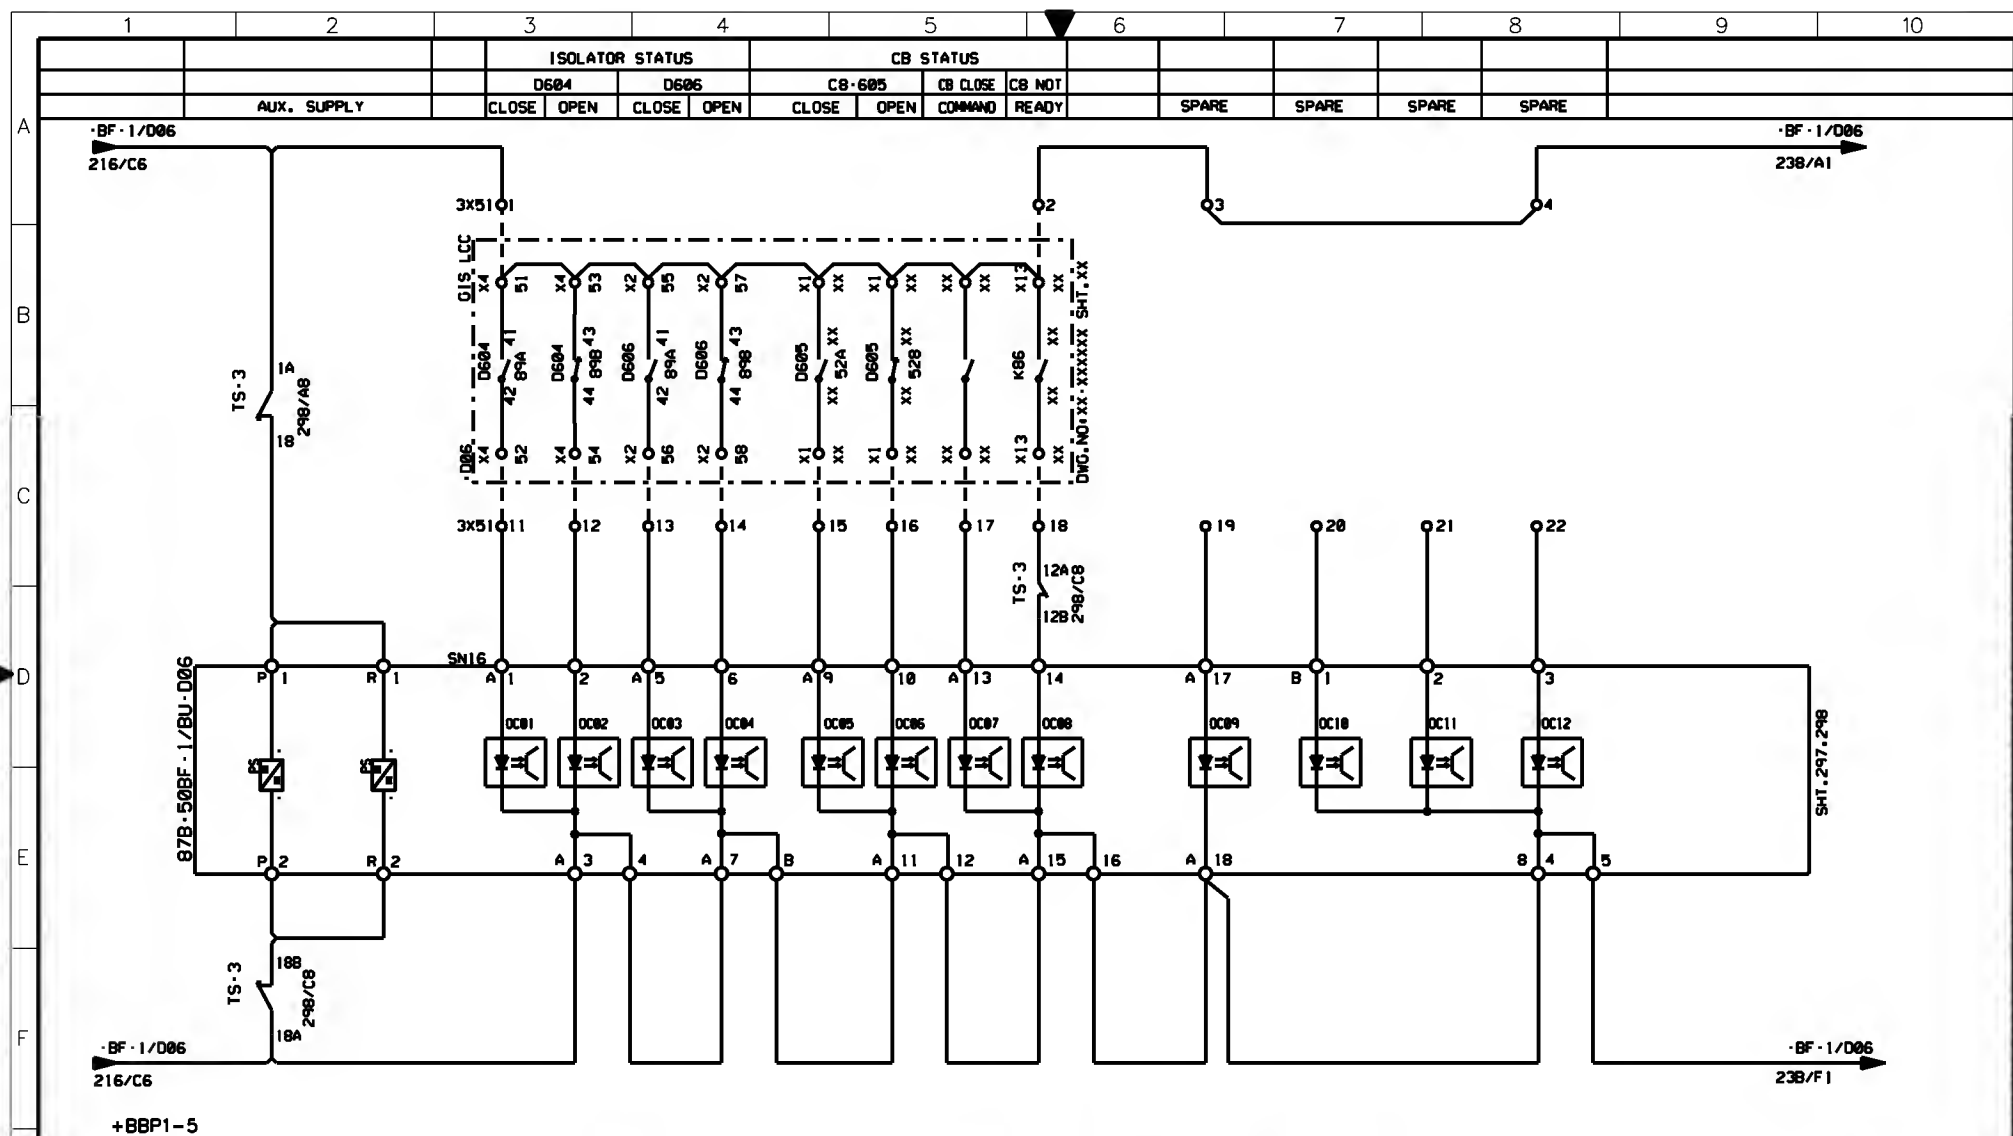


AS-BUILT BY _____ DATE _____ CONTRACT NO. 1113113/00 JOB ORDER NO. S-13656

01	13 49	FACTORY ASBUILT
00	13 05	FOR APPROVAL
REV. NO.	DATE	DESCRIPTION


DRAWN BY RIZ CHECKED BY KVR
 DATE STARTED 28.01.2013 DATE COMPLETED _____
 OPRG. DEPT. CTPO ENG. DEPT. AUT-PSAC

87B-50BF-1/BU-D06 PROTECTION RELAY - BINARY INPUTS
132KV BUSBAR PROTN.MAIN-1 BU PANEL +BBP1-5
S/S 8709 - 132/13.8KV IN AL-KHARJ CITY
RIYADH SAUDI ARABIA


الشركة الوطنية لنقل الكهرباء		National Grid sa	
INDEX	PLANT NO.	DRAWING NUMBER	SHEET NO.
-	C421	CD-322999	237 238
			REV. NO.
			01

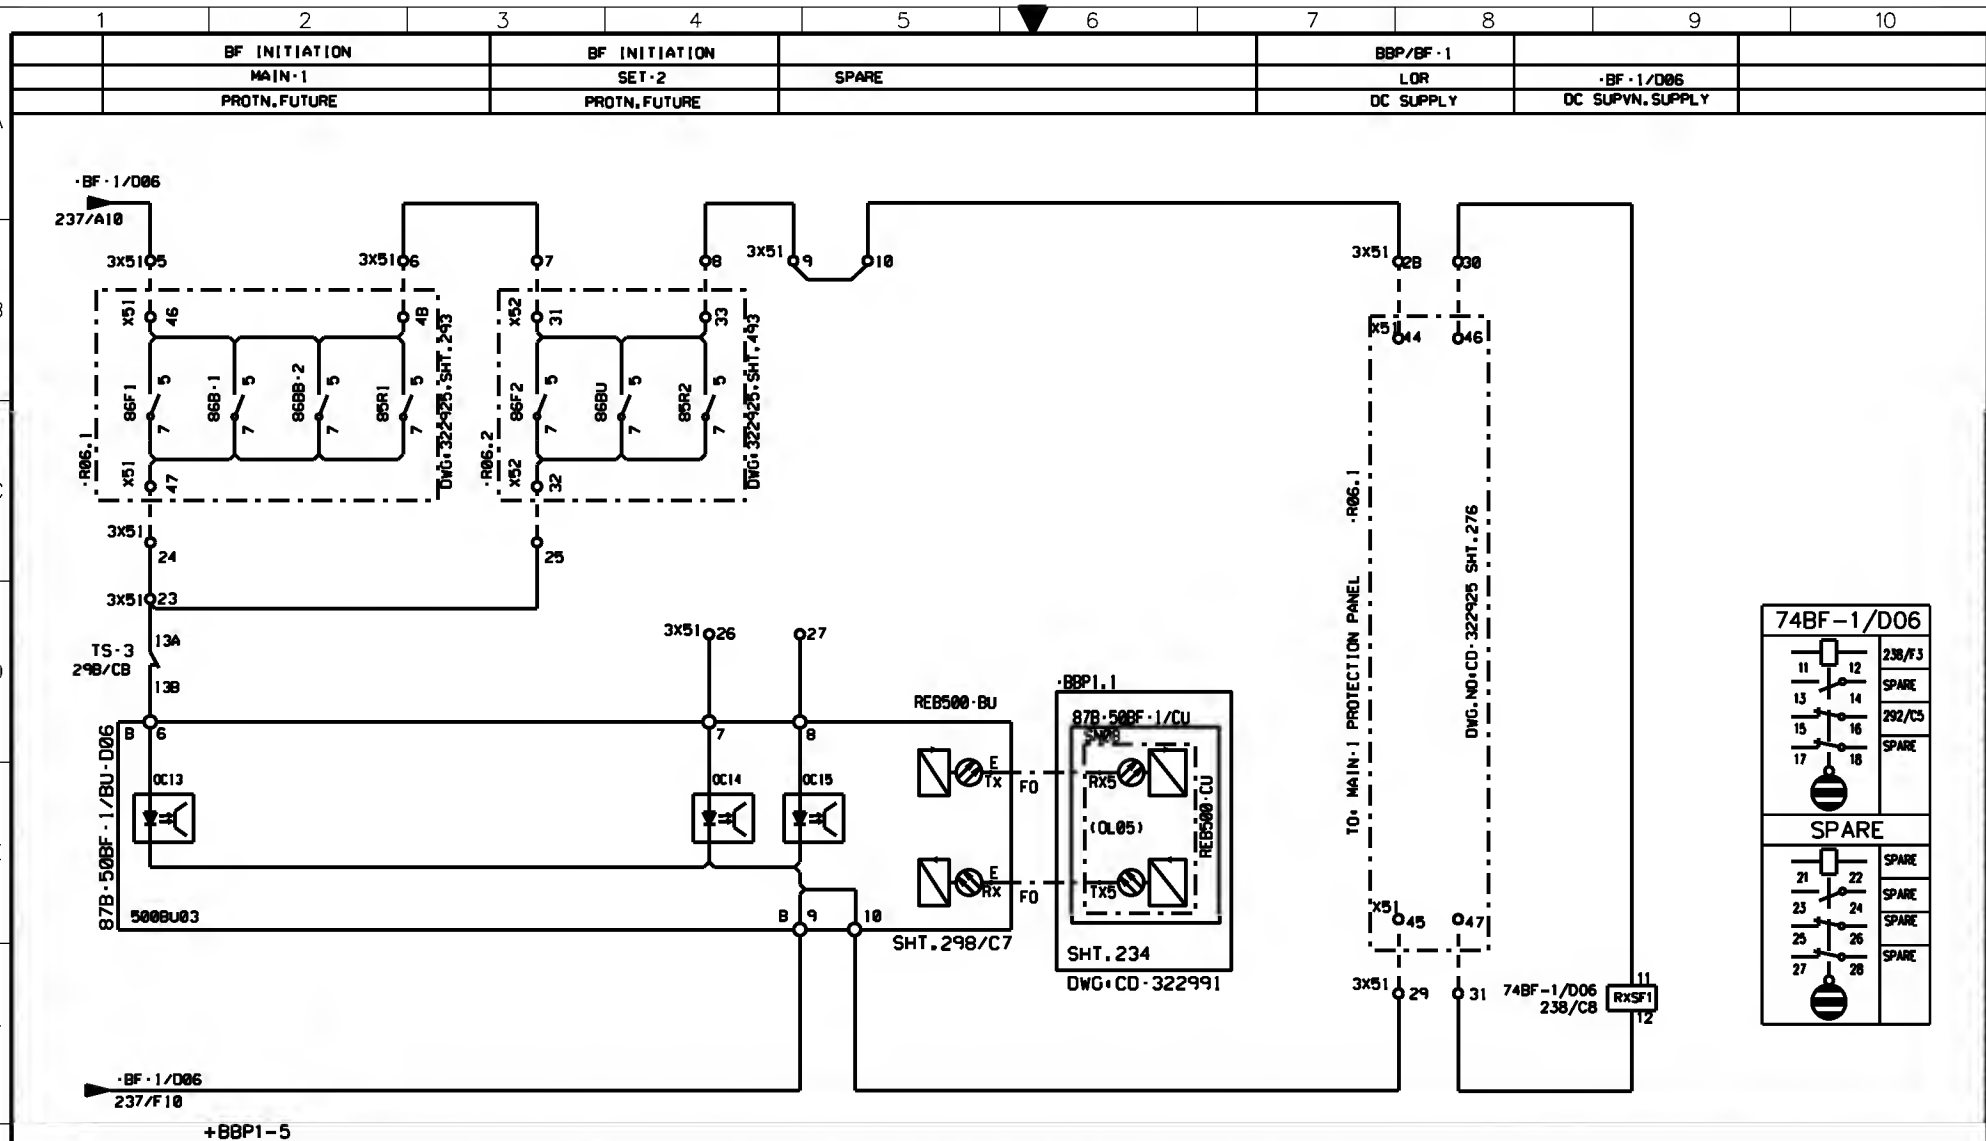


AS-BUILT BY _____ DATE _____		CONTRACT NO. 1113113/00	JOB ORDER NO. S-13656	87B-50BF-1/BU-D06 PROTECTION RELAY - BINARY INPUTS		الشركة الوطنية لنقل الكهرباء		نقل الكهرباء	
01	13 49	FACTORY ASBUILT FOR APPROVAL	DRAWN BY RIZ CHECKED BY KVR	132KV BUSBAR PROTN.MAIN-1 BU PANEL +BBP1-5		INDEX	PLANT NO.	DRAWING NUMBER	SHEET NO.
00	13 05		DATE STARTED 28.01.2013 DATE COMPLETED _____	S/S 8709 - 132/13.8KV IN AL-KHARJ CITY		-	C421	CD-322999	238
REV. NO.	DATE	DESCRIPTION	OPRG. DEPT. CTPD ENG. DEPT. AUT-PSAC	RIYADH SAUDI ARABIA		CONT.		239	
								01	

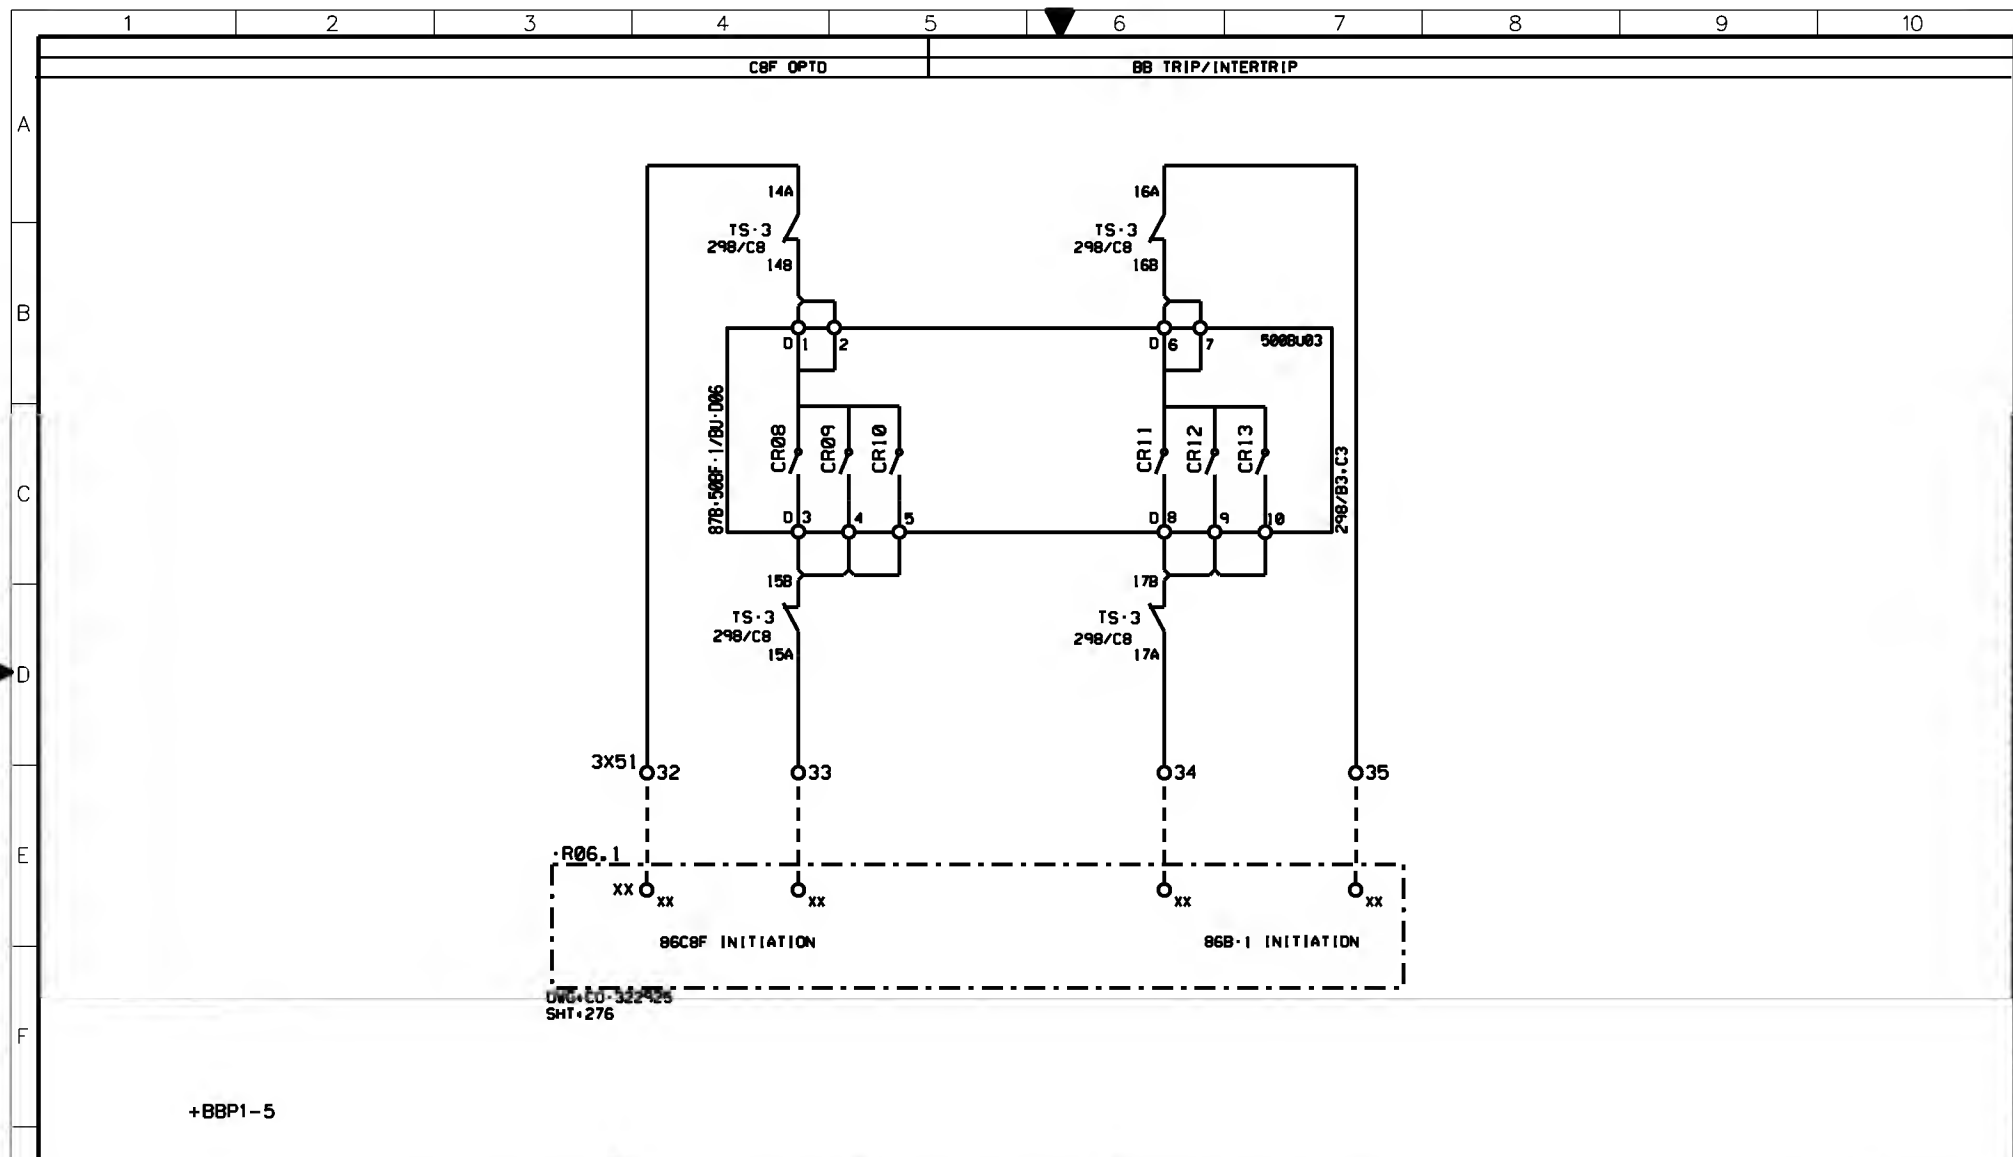


AS-BUILT BY _____ DATE _____			CONTRACT NO. 1113113/00		JOB ORDER NO. S-13656		CBF-1 & BUSBAR PROTN-1 TRIP RELAY CIRCUIT				الشركة الوطنية لنقل الكهرباء			
01 13 49			DRAWN BY RIZ		CHECKED BY KVR		132KV BUSBAR PROTN.MAIN-1 BU PANEL +BBP1-5				National Grid sa			
00 13 05			DATE STARTED 28.01.2013		DATE COMPLETED _____		S/S 8709 - 132/13.8KV IN AL-KHARJ CITY				INDEX PLANT NO. DRAWING NUMBER SHEET NO. REV. NO.			
REV. NO. DATE DESCRIPTION			OPRG. DEPT. CTPD		ENG. DEPT. AUT-PSAC		RIYADH SAUDI ARABIA				- C421 CD-322999 239 292 01			

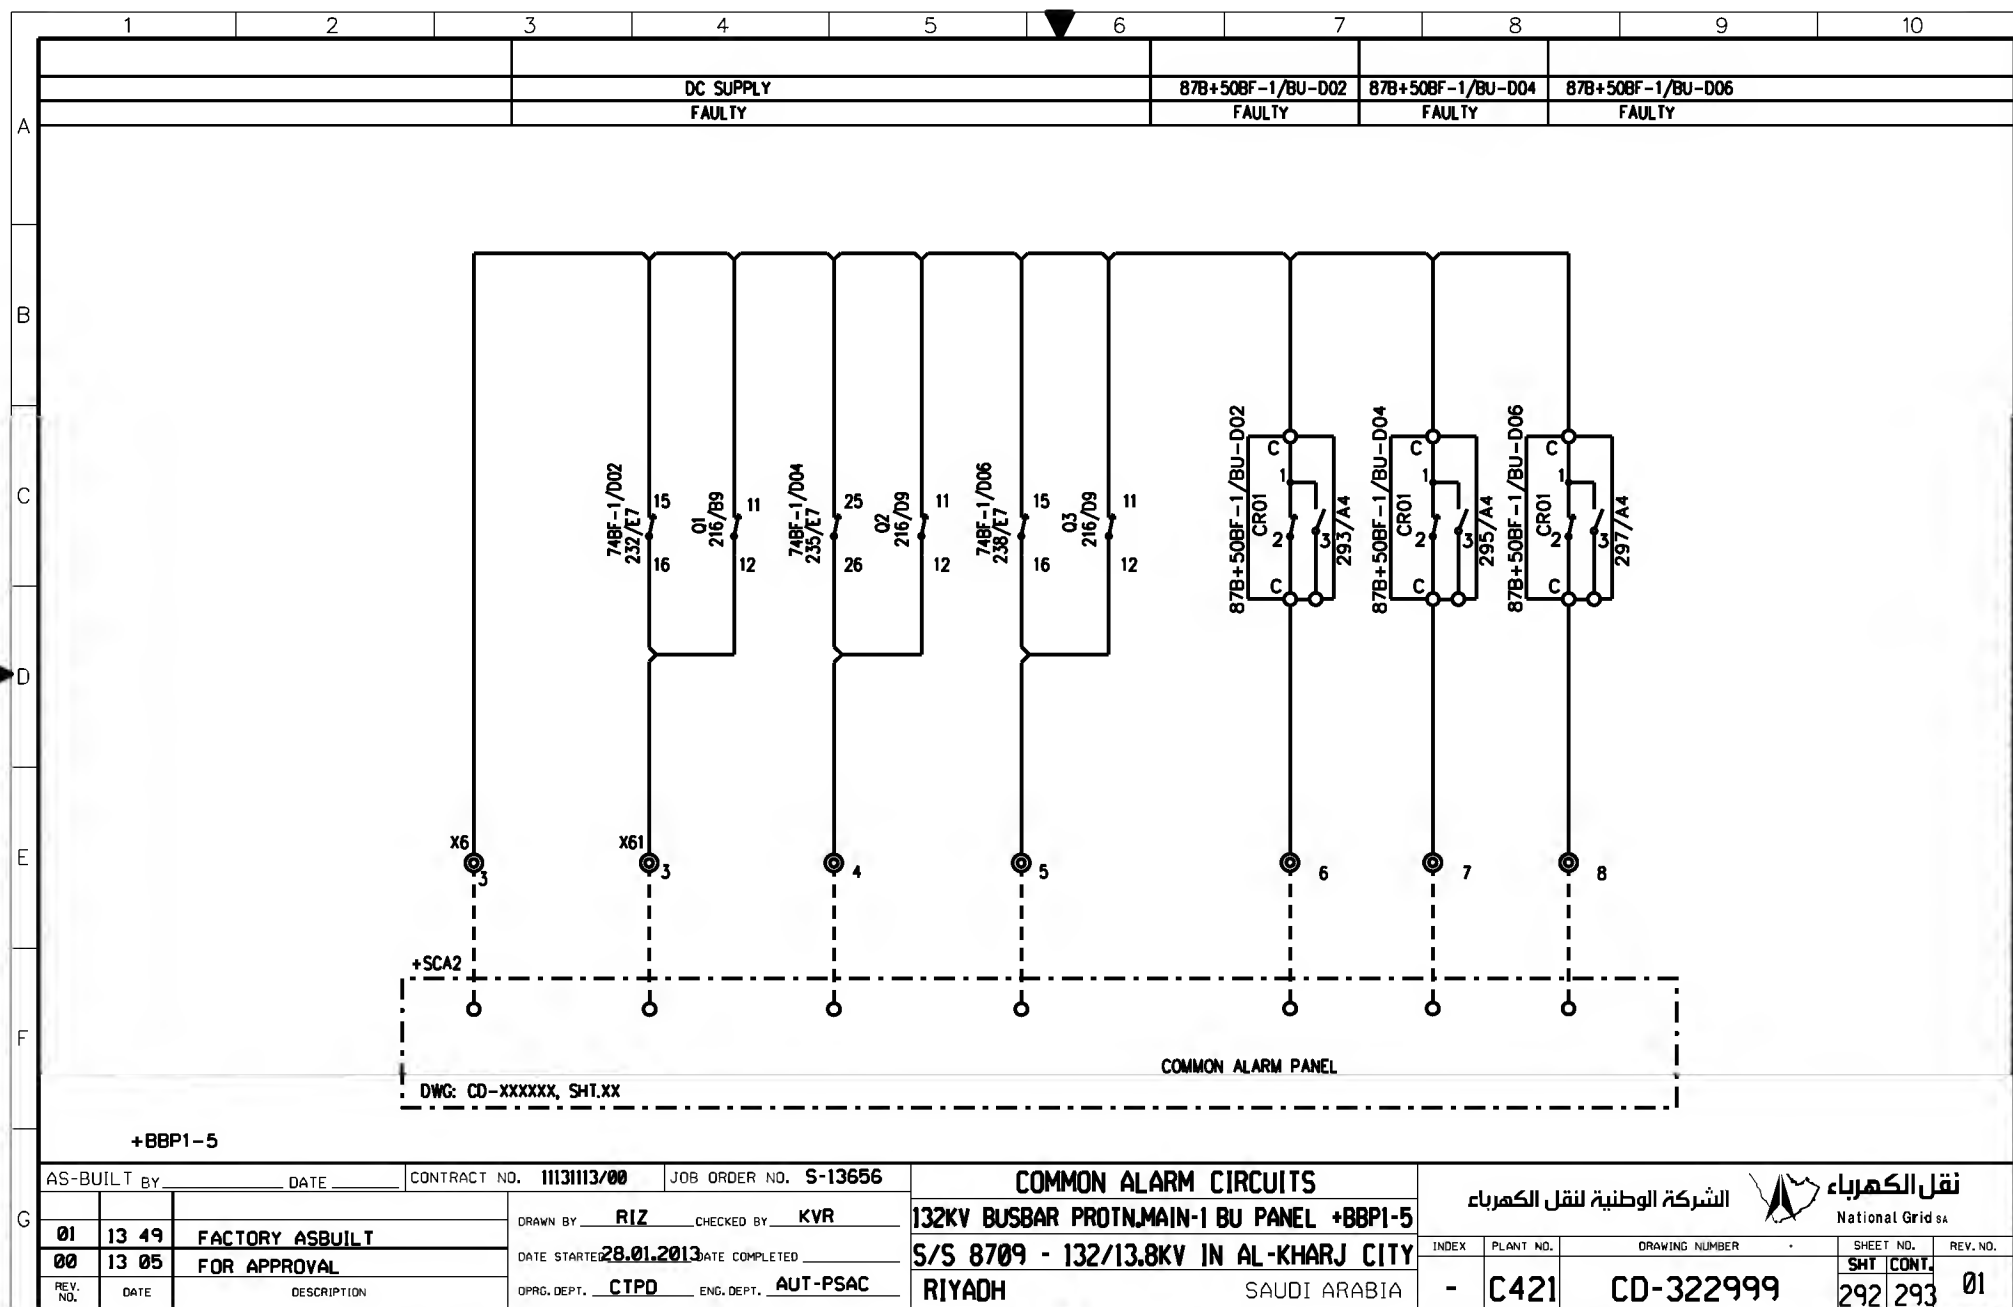


AS-BUILT BY _____ DATE _____			CONTRACT NO. 1113113/00		JOB ORDER NO. S-13656		COMMON ALARM CIRCUITS				نقل الكهرباء الشركة الوطنية لنقل الكهرباء National Grid sa							
DRAWN BY RIZ CHECKED BY KVR			132KV BUSBAR PROTN.MAIN-1 BU PANEL +BBP1-5				INDEX				PLANT NO.		DRAWING NUMBER		SHEET NO.		REV. NO.	
DATE STARTED 28.01.2013 DATE COMPLETED _____			S/S 8709 - 132/13.8KV IN AL-KHARJ CITY				-				C421		CD-322999		SHT		CONT.	
OPRG. DEPT. CTPD ENG. DEPT. AUT-PSAC			RIYADH SAUDI ARABIA												292		293	
REV. NO. DATE DESCRIPTION																		
01 13 49 FACTORY ASBUILT																		
00 13 05 FOR APPROVAL																		

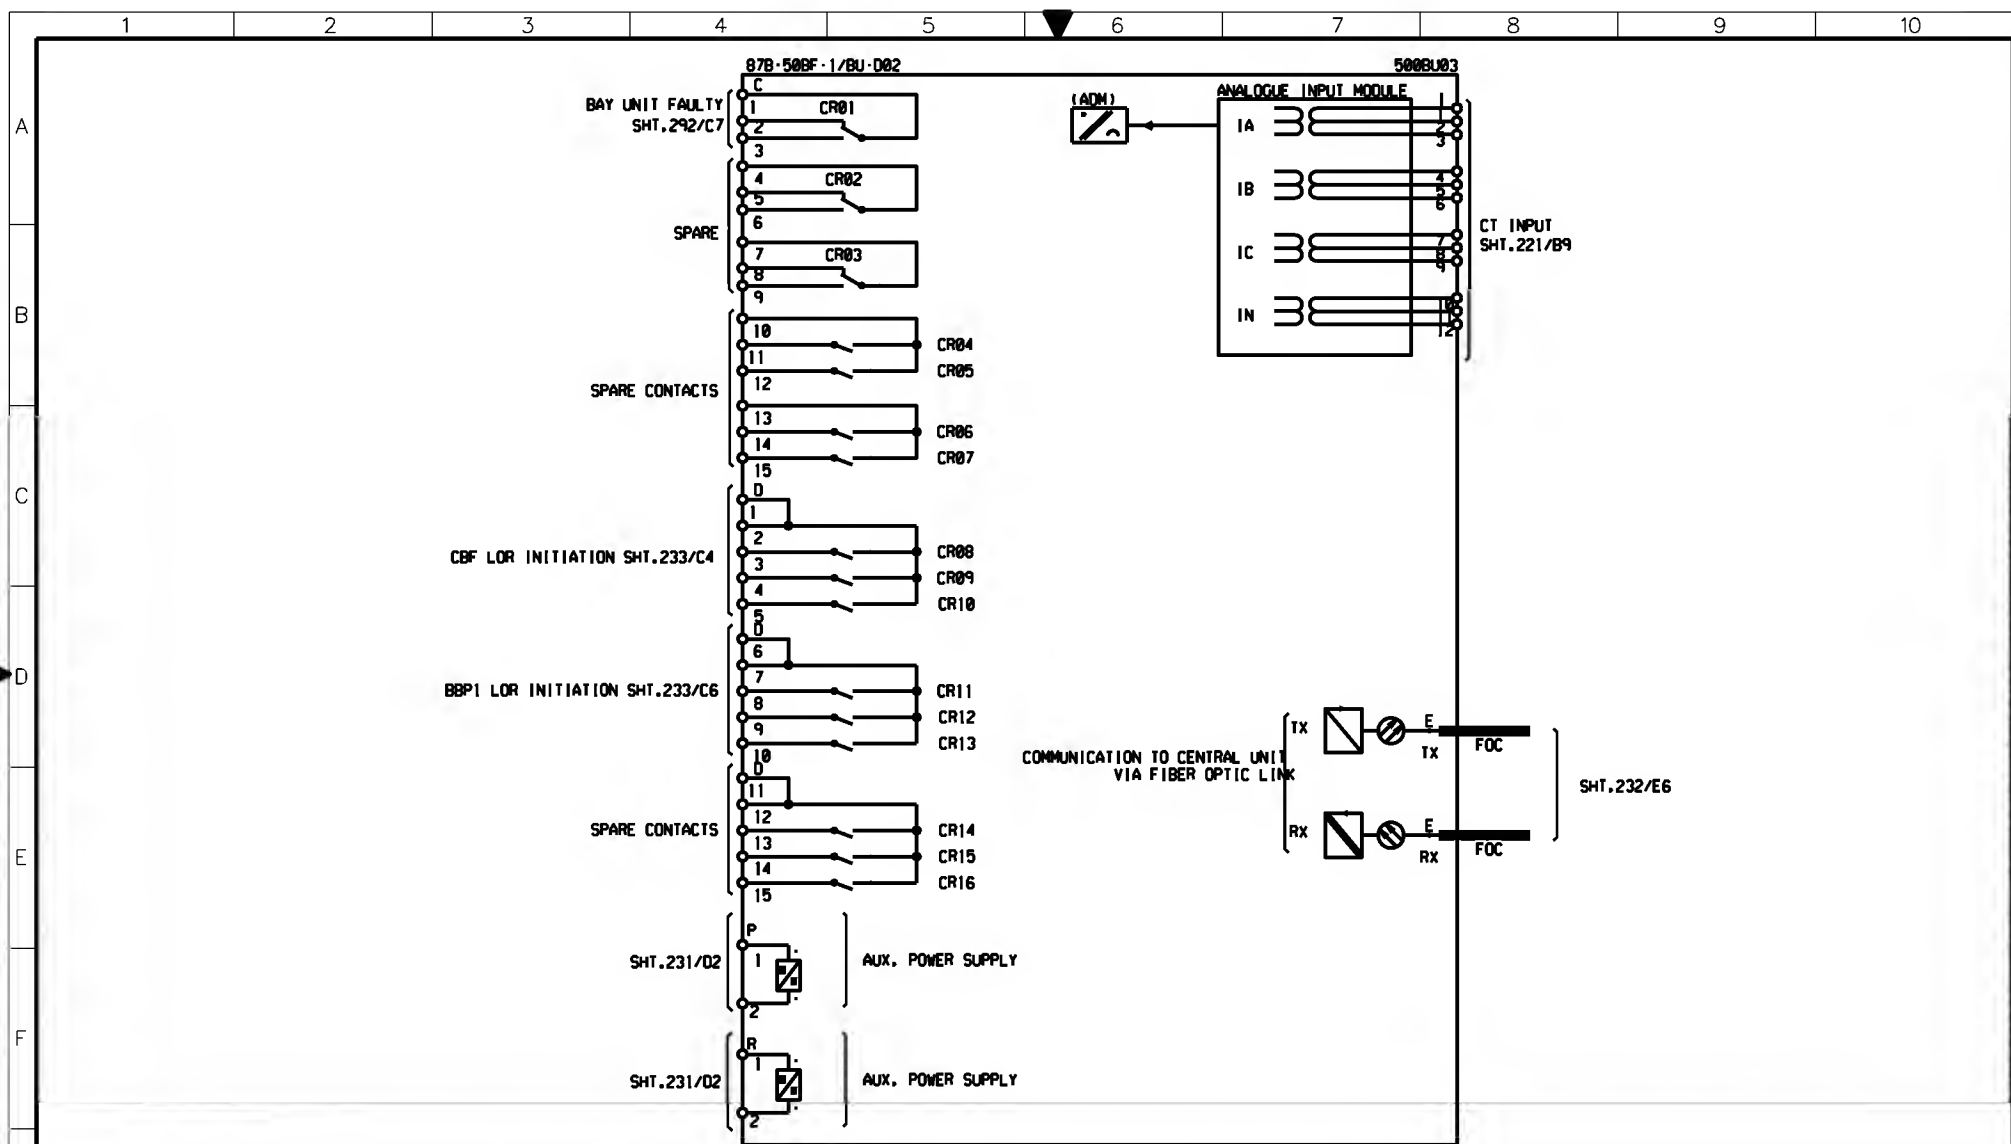


AS-BUILT BY _____ DATE _____			CONTRACT NO. 1113113/00		JOB ORDER NO. S-13656		BLOCK REFERENCE-87B+50BF-1/BU-D02			نقل الكهرباء الشركة الوطنية لنقل الكهرباء National Grid sa				
			DRAWN BY RIZ		CHECKED BY KVR		132KV BUSBAR PROTN.MAIN-1 BU PANEL +BBPI-5			INDEX	PLANT NO.	DRAWING NUMBER	SHEET NO.	REV. NO.
			DATE STARTED 28.01.2013		DATE COMPLETED		S/S 8709 - 132/13.8KV IN AL-KHARJ CITY						SHT CONT.	
01 13 49			FACTORY ASBUILT				RIYADH			-	C421	CD-322999	293	01
00 13 05			FOR APPROVAL				SAUDI ARABIA						294	
REV. NO.			DATE		DESCRIPTION		OPRG. DEPT. CTPD		ENG. DEPT. AUT-PSAC					

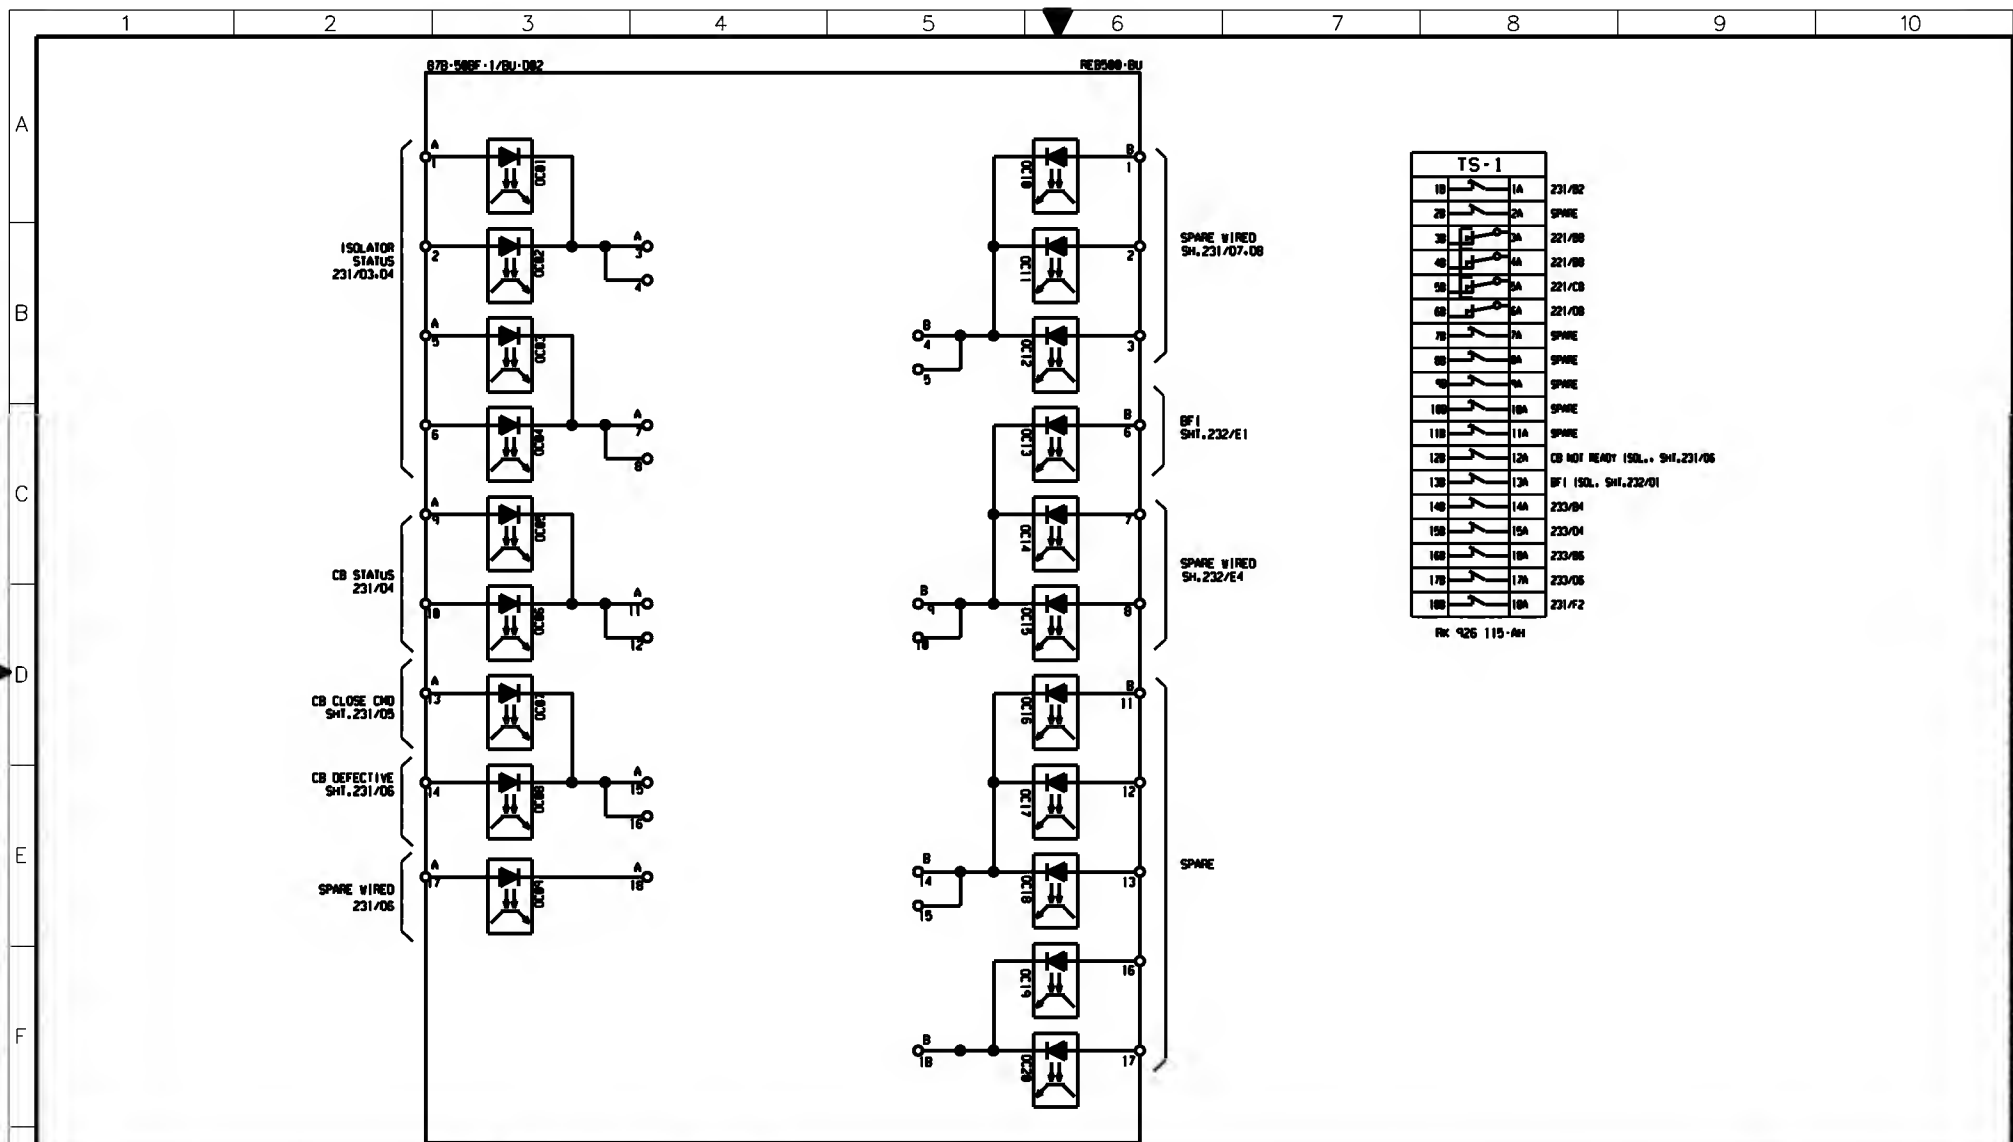


AS-BUILT BY _____ DATE _____		CONTRACT NO. 1113113/00	JOB ORDER NO. S-13656	BLOCK REFERENCE-87B+50BF-1/BU-002		الشركة الوطنية لنقل الكهرباء	
01	13 49	FACTORY ASBUILT FOR APPROVAL	DRAWN BY RIZ CHECKED BY KVR	132KV BUSBAR PROTN. MAIN-1 BU PANEL +88P1-5		نقل الكهرباء National Grid sa	
00	13 05		DATE STARTED 28.01.2013 DATE COMPLETED _____	\$/S 8709 - 132/13.8KV IN AL-KHARJ CITY		INDEX	PLANT NO.
REV. NO.	DATE	DESCRIPTION	OPRG. DEPT. CTPD ENG. DEPT. AUT-PSAC	RIYADH SAUDI ARABIA		-	C421
						DRAWING NUMBER	SHEET NO.
						CD-322999	294 295
						REV. NO.	01

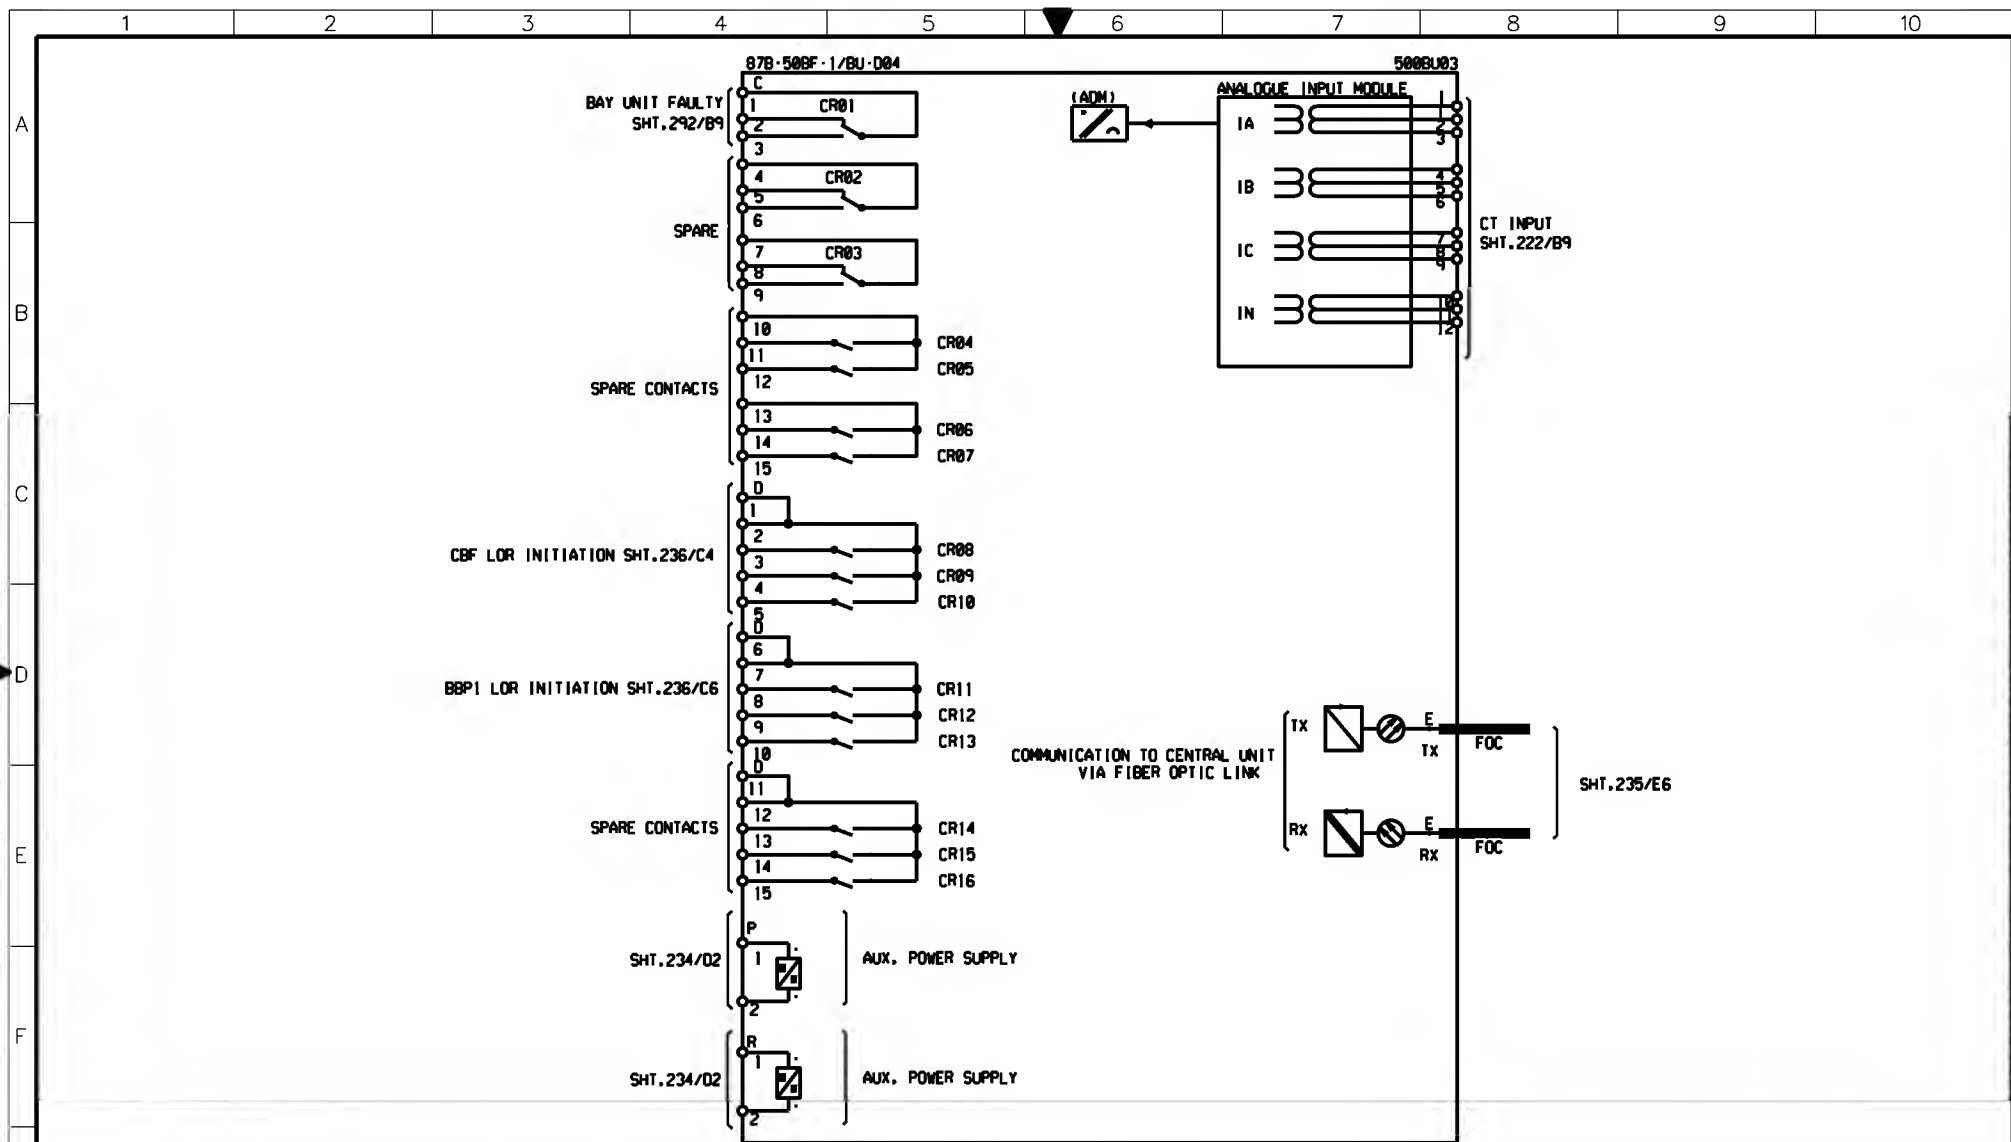


AS-BUILT BY _____ DATE _____			CONTRACT NO. 11131113/00		JOB ORDER NO. S-13656		BLOCK REFERENCE-87B+50BF-2/BU-D04			الشركة الوطنية لنقل الكهرباء National Grid sa							
			DRAWN BY RIZ CHECKED BY KVR		132KV BUSBAR PROTN.MAIN-1 BU PANEL +BBP1-5												
01 13 49 FACTORY ASBUILT			DATE STARTED 28.01.2013 DATE COMPLETED _____		S/S 8709 - 132/13.8KV IN AL-KHARJ CITY			INDEX		PLANT NO.		DRAWING NUMBER		SHEET NO.		REV. NO.	
00 13 05 FOR APPROVAL			OPRG. DEPT. CTPD ENG. DEPT. AUT-PSAC		RIYADH SAUDI ARABIA			-		C421		CD-322999		295 296		01	
REV. NO. DATE DESCRIPTION																	

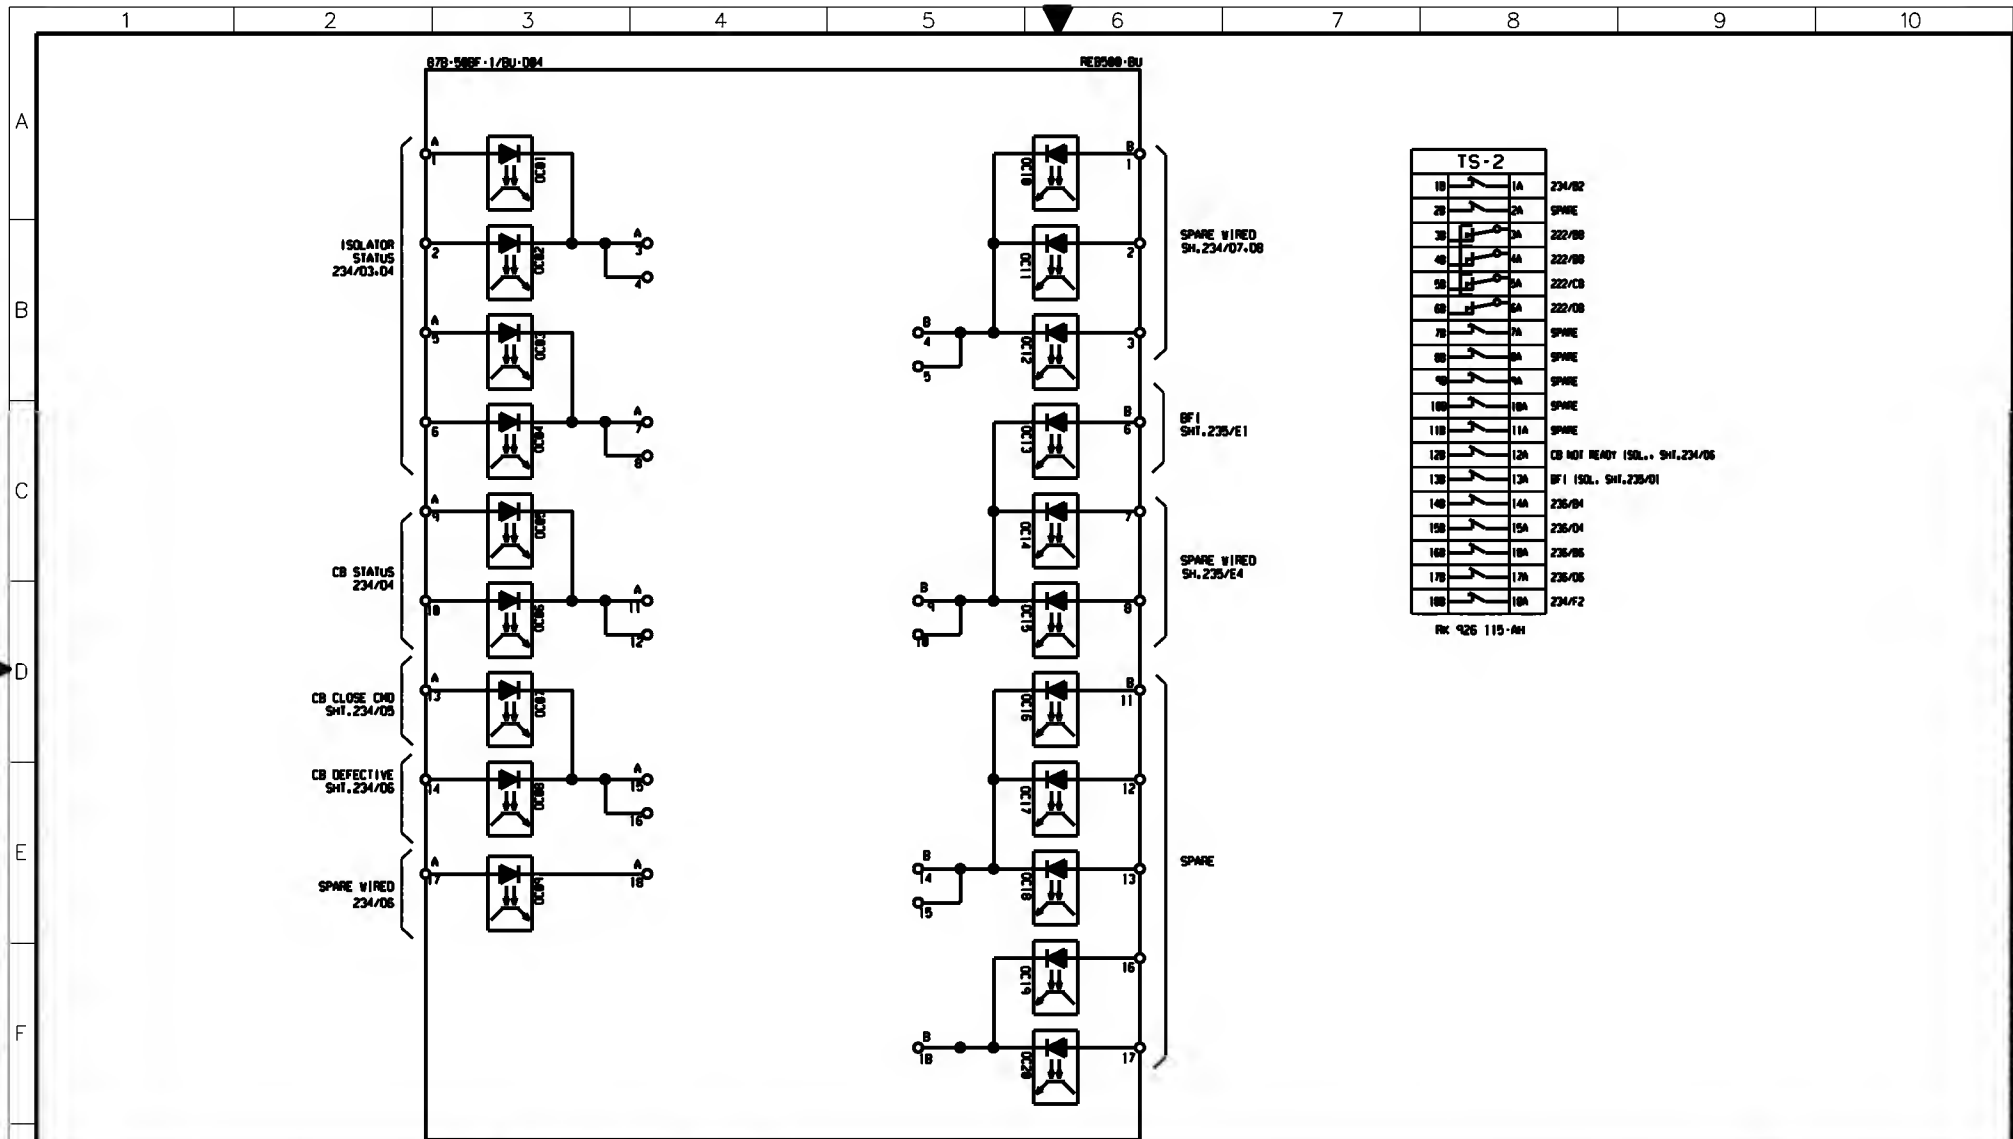


AS-BUILT BY _____ DATE _____		CONTRACT NO. 1113113/00		JOB ORDER NO. S-13656		BLOCK REFERENCE-878+50BF-2/BU-004		الشركة الوطنية لنقل الكهرباء		نقل الكهرباء	
DRAWN BY RIZ		CHECKED BY KVR		DATE STARTED 28.01.2013		DATE COMPLETED _____		132KV BUSBAR PROTN. MAIN-1 BU PANEL +BBP1-5		National Grid sa	
PRG. DEPT. CTPD		ENG. DEPT. AUT-PSAC		S/S 8709 - 132/13.8KV IN AL-KHARJ CITY		RIYADH		SAUDI ARABIA		INDEX PLANT NO. C421	
DRAWING NO. 01		DATE 13 49		DESCRIPTION FACTORY ASBUILT		DRAWING NUMBER CD-322999		SHEET NO. 296		REV. NO. 01	
REV. NO. 00		DATE 13 05		DESCRIPTION FOR APPROVAL		DRAWING NUMBER CD-322999		SHEET NO. 297		REV. NO. 01	

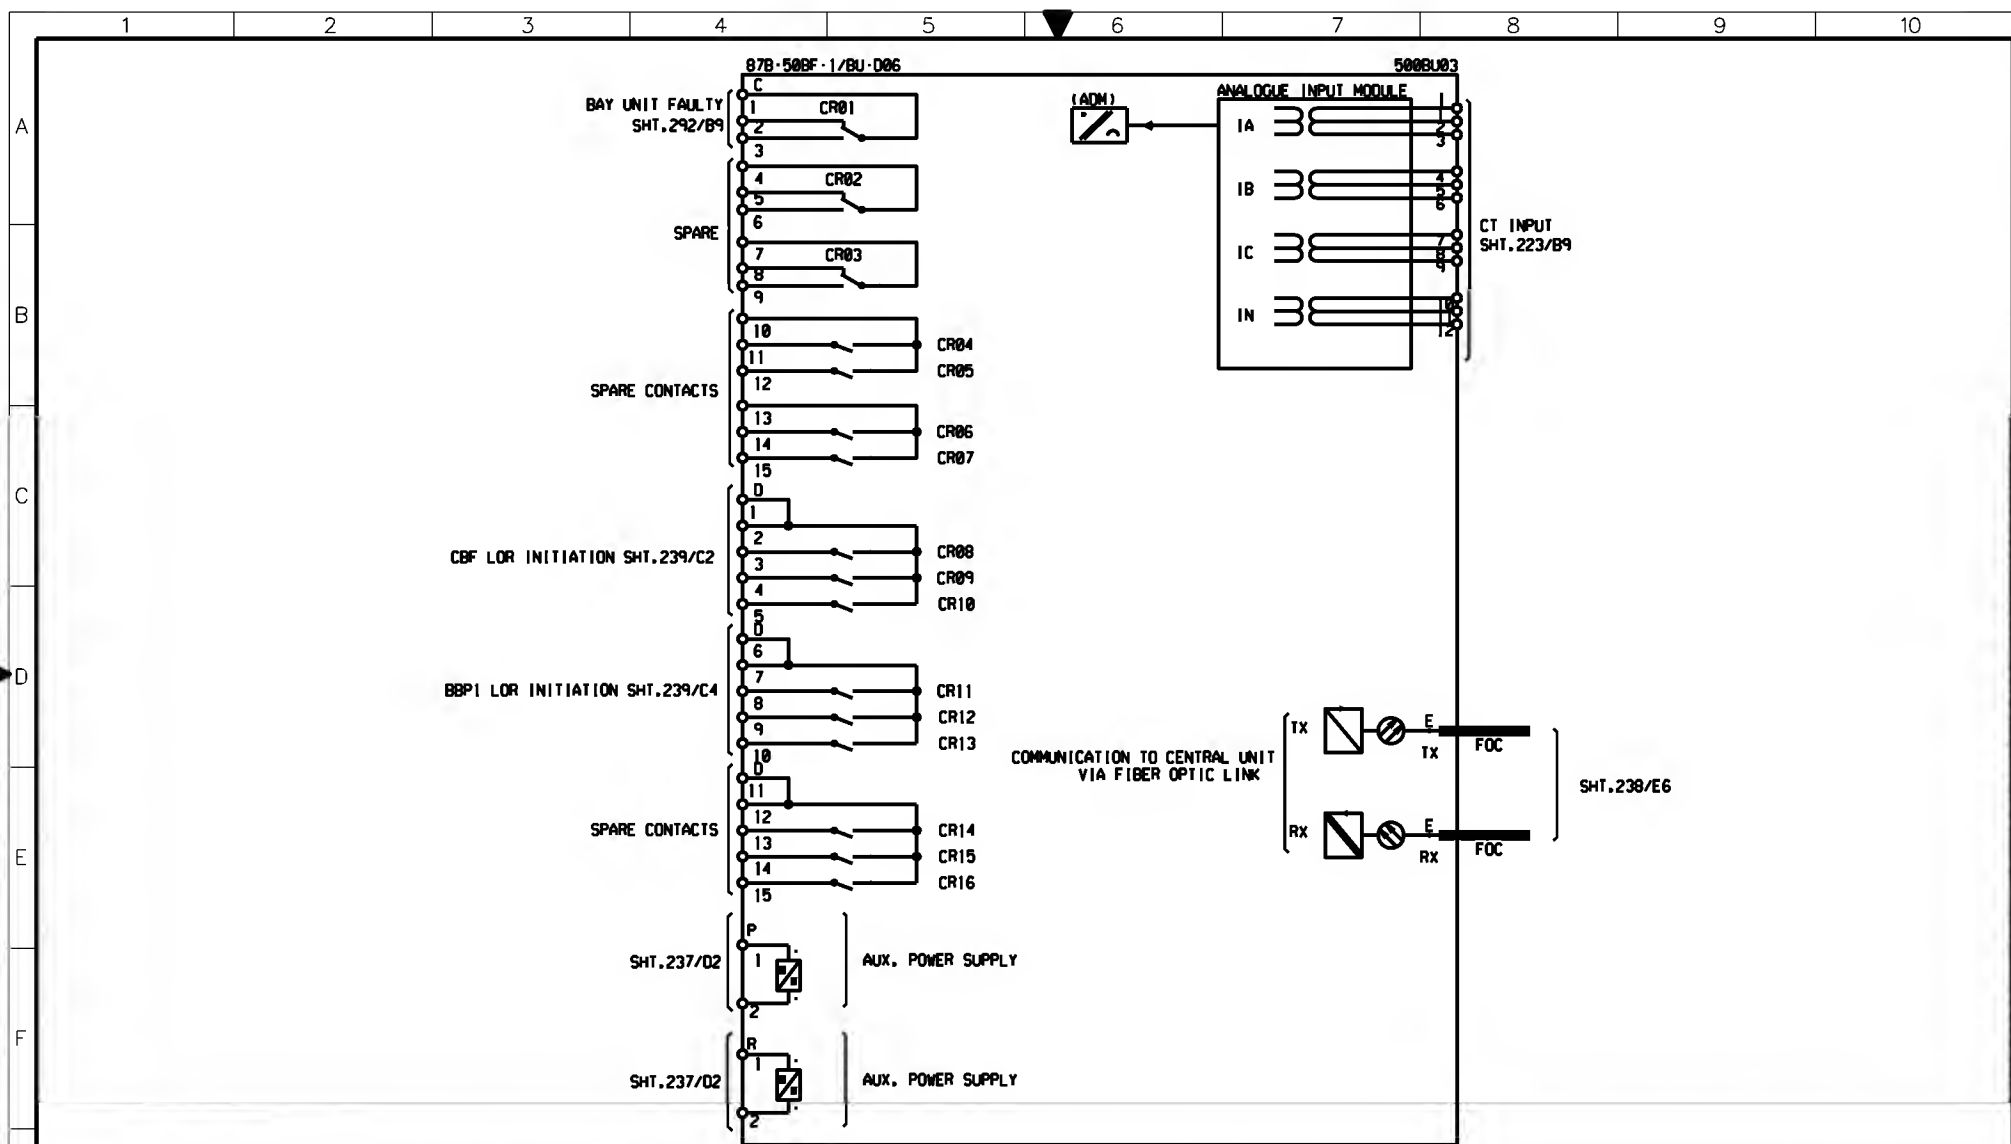

AS-BUILT BY _____ DATE _____			CONTRACT NO. 11131113/00		JOB ORDER NO. S-13656		BLOCK REFERENCE-87B+50BF-1/BU-D06			الشركة الوطنية لنقل الكهرباء			
DRAWN BY RIZ CHECKED BY KVR			DATE STARTED 28.01.2013 DATE COMPLETED _____		DATE STARTED _____ DATE COMPLETED _____		132KV BUSBAR PROTN. MAIN-1 BU PANEL +BBPI-5			National Grid sa			
FOR APPROVAL			PRG. DEPT. CTPD ENG. DEPT. AUT-PSAC		S/S 8709 - 132/13.8KV IN AL-KHARJ CITY		RIYADH			SAUDI ARABIA			
REV. NO.	DATE	DESCRIPTION	INDEX		PLANT NO.		DRAWING NUMBER		SHEET NO.		REV. NO.		
01	13 49	FACTORY ASBUILT	-		C421		CD-322999		297		01		
00	13 05	FOR APPROVAL	-		-		-		298		01		

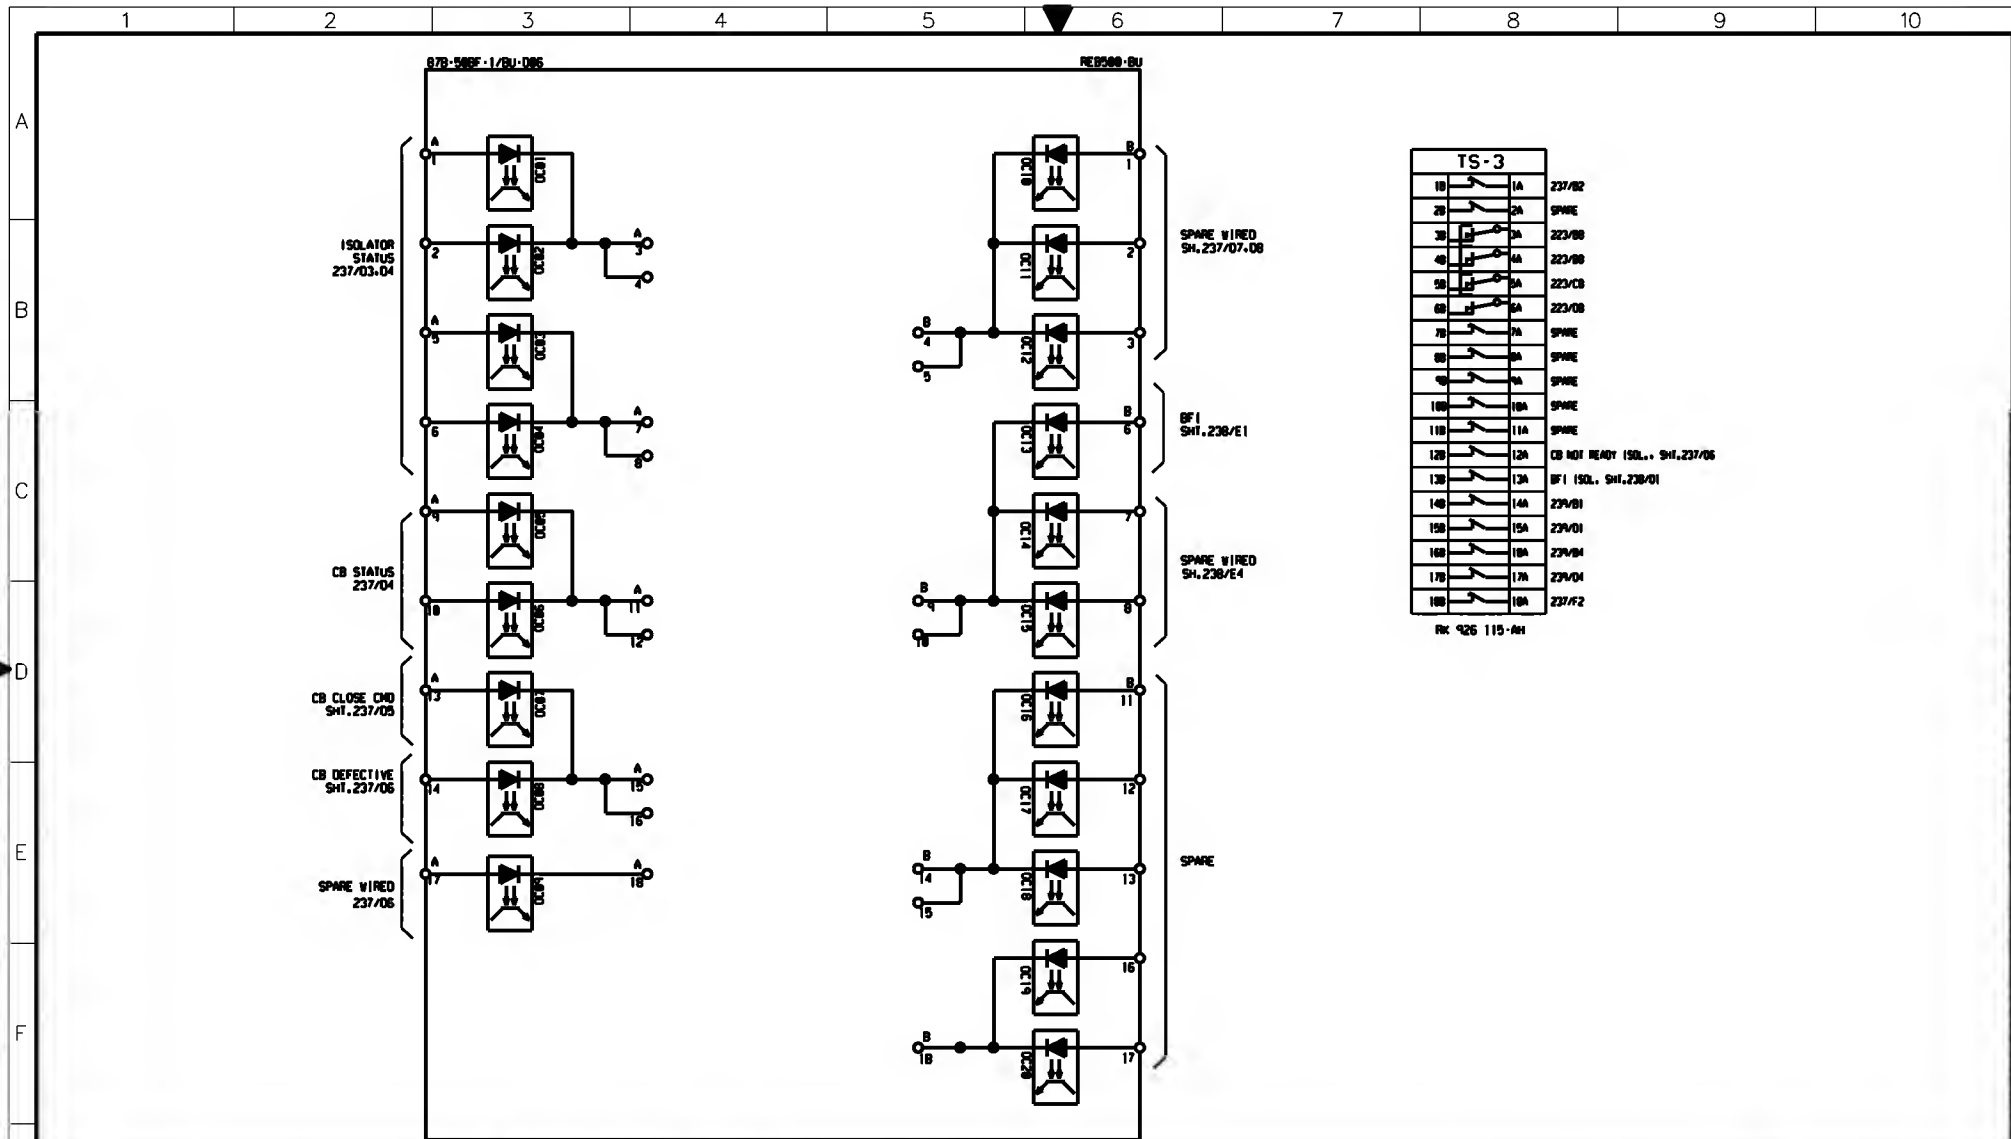

TS-3			
10	1A	237/02	
20	2A	SPARE	
30	3A	223/00	
40	4A	223/00	
50	5A	223/00	
60	6A	223/00	
70	7A	SPARE	
80	8A	SPARE	
90	9A	SPARE	
100	10A	SPARE	
110	11A	SPARE	
120	12A	CB NOT READY (SOL.) SH.237/06	
130	13A	BF1 (SOL.) SH.230/01	
140	14A	237/01	
150	15A	237/01	
160	16A	237/01	
170	17A	237/01	
180	18A	237/02	
Rk 926 115-AH			

AS-BUILT BY _____ DATE _____			CONTRACT NO. 1113113/00		JOB ORDER NO. S-13656		BLOCK REFERENCE-87B+50BF-1/BU-006		الشركة الوطنية لنقل الكهرباء						نقل الكهرباء			
			DRAWN BY RIZ		CHECKED BY KVR		132KV BUSBAR PROTN.MAIN-1 BU PANEL +BBP1-5		INDEX		PLANT NO.		DRAWING NUMBER		SHEET NO.		REV. NO.	
01 13 49			FACTORY ASBUILT		DATE STARTED 28.01.2013		S/S 8709 - 132/13.8KV IN AL-KHARJ CITY											
00 13 05			FOR APPROVAL		DATE COMPLETED _____		RIYADH SAUDI ARABIA		-		C421		CD-322999		SHT CONT.		01	
REV. NO.			DATE		DESCRIPTION		OPRG. DEPT. CTPD ENG. DEPT. AUT-PSAC								298 301			

REFERENCE

221/B7

221/B7

221/C7

221/C7

221/D7

221/D7

SPARE

1X1 CT CKT.

1

2

3

4

5

6

7

8

9

10

REFERENCE

222/B7

222/B7

222/C7

222/C7

222/D7

222/D7

SPARE

2X1 CT CKT.

1

2

3

4

5

6

7

8

9

10

REFERENCE

223/B7

223/B7

223/C7

223/C7

223/D7

223/D7

SPARE

3X1 CT CKT.

1

2

3

4

5

6

7

8

9

10

REFERENCE

231/A3

231/A5

231/A6

231/A6

232/A1

232/A2

232/A2

232/A3

232/A4

232/A4

231/C3

231/C3

231/C4

231/C4

231/C4

231/C5

231/C5

231/C8

231/C8

231/C7

231/C8

231/C8

232/D1

232/C1

232/C3

232/D4

232/D5

232/B6

232/F6

232/B6

232/F6

233/E4

233/E4

233/E6

233/E7

SPARE

SPARE

1X51 CON & PROTIN CKTS.

1

2

3

REFERENCE

234/A3

234/A5

234/A6

234/A6

235/A1

235/A2

235/A2

235/A3

235/A4

235/A4

234/C3

234/C3

234/C4

234/C4

234/C4

234/C5

234/C5

234/C8

234/C8

234/C8

234/C7

234/C8

234/C8

235/D1

235/C1

235/C3

235/D4

235/D5

235/B6

235/F6

235/B6

235/F6

236/E4

236/E4

236/E6

236/E7

SPARE

SPARE

2X51 CON & PROTIN CKTS.

1

2

3

REFERENCE

237/A3

237/A5

237/A6

237/A6

238/A1

238/A2

238/A2

238/A3

238/A4

238/A4

237/C3

237/C3

237/C4

237/C4

237/C4

237/C5

237/C5

237/C8

237/C8

237/C8

237/C7

237/C8

237/C8

238/D1

238/C1

238/C3

238/D4

238/D5

238/B6

238/F6

238/B6

238/F6

239/E4

239/E4

239/E6

239/E7

SPARE

SPARE

3X51 CON & PROTIN CKTS.

1

2

3

REFERENCE

212/E5

212/E5

292/E4

292/E5

292/E6

292/E7

292/E6

292/E6

SPARE

SPARE

X61 ALM. CKT.

1

2

3

REFERENCE

211/A3

211/A7

211/A3

211/A7

211/B3

211/B7

211/B3

211/B7

SPARE

SPARE

X3 AC CKT.

1

2

3

4

5

6

7

8

9

10

REFERENCE

211/C3

211/D3

211/D3

211/D3

SPARE

XTJ T.JACK

1

2

3

4

5

REFERENCE

216/B3

216/B3

216/D3

216/D3

SPARE

SPARE

X4 DC CKTS.

1

2

3

4

5

6

7

8

9

10

REFERENCE

211/E6

211/F6

SPARE

XSH SPACE HEATER

1

2

3

REFERENCE

212/C5

212/C8

292/E3

SPARE

SPARE

X6 ALM. CKT.

1

2

3

4

5

1

2

3

4

5

6

7

8

9

10

AS-BUILT BY _____ DATE _____		CONTRACT NO. 11131113/00		JOB ORDER NO. S-13656		TERMINAL BLOCKS PANEL +BB1-5		الشركة الوطنية لنقل الكهرباء		نقل الكهرباء	
01 13 49		FACTORY ASBUILT		DRAWN BY RIZ CHECKED BY KVR		132KV BUSBAR PROTIN MAIN-1 BU PANEL +BBP1-5		INDEX		PLANT NO.	
00 13 05		FOR APPROVAL		DATE STARTED 28.01.2013 DATE COMPLETED _____		S/S 8709 - 132/13.8KV IN AL-KHARJ CITY		DRAWING NUMBER		SHEET NO.	
REV. NO.		DATE		DESCRIPTION		PRG. DEPT. CTPD ENG. DEPT. AUT-PSAC		- C421		CD-322999	
						RIYADH SAUDI ARABIA				301 NIL	
										01	